

15-151-10609-0000


STATE OF KANSAS
STATE CORPORATION COMMISSION

WELL PLUGGING RECORD

Give All Information Completely
Make Required Affidavit
Mail or Deliver Report to:
Conservation Division
State Corporation Commission
211 No. Broadway
Wichita, Kansas

Pratt County. Sec. 28 Twp. 26 Rge. 12 XEX (W)

NORTH

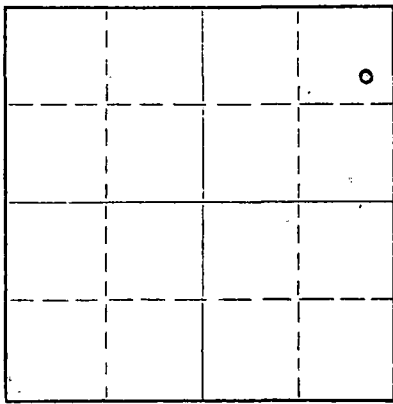

Locate well correctly on above
Section Plat

Location as "NE/CNW/SW" or footage from lines SE/4 NE/4 NE/4
Lease Owner Pan American Petroleum Corporation
Lease Name Gertrude Hall Well No. 3
Office Address Box 1654, Oklahoma City, Oklahoma
Character of Well (completed as Oil, Gas or Dry Hole) Dry Hole
Date well completed 4-25- 19 57
Application for plugging filed 4-26- 19 57
Application for plugging approved 4-25- 19 57
Plugging commenced 4-26- 19 57
Plugging completed 4-26- 19 57
Reason for abandonment of well or producing formation No commercial quantities
of oil or gas were encountered

If a producing well is abandoned, date of last production _____ 19____
Was permission obtained from the Conservation Division or its agents before plugging was commenced? Yes

Name of Conservation Agent who supervised plugging of this well M. A. Rives
Producing formation None Depth to top _____ Bottom _____ Total Depth of Well 4353 Feet
Show depth and thickness of all water, oil and gas formations.

OIL, GAS OR WATER RECORDS

CASING RECORD

FORMATION	CONTENT	FROM	TO	SIZE	PUT IN	PULLED OUT
Arbuckle	Water	4313	4353	8-5/8	751	None

Describe in detail the manner in which the well was plugged, indicating where the mud fluid was placed and the method or methods used in introducing it into the hole. If cement or other plugs were used, state the character of same and depth placed, from _____ feet to _____ feet for each plug set.

Hvy Mud	4353-300
Wood Plug	300-297
35 Sx Cement	297-100
Hvy Mud	100- 35
Wood Bridge	35- 32
15 Sx Cement	32 To Bottom of Cellar

RECEIVED
STATE CORPORATION COMMISSION
4-27-57
APR 27 1957
CONSERVATION DIVISION
Wichita, Kansas

(If additional description is necessary, use BACK of this sheet)
Name of Plugging Contractor Herndon Drilling Company
Address Tulsa, Oklahoma

STATE OF KANSAS, COUNTY OF BARTON, ss.
I, F. H. Butcher (employee of owner) or ~~owner or operator~~ of the above-described well, being first duly sworn on oath, says: That I have knowledge of the facts, statements, and matters herein contained and the log of the above-described well as filed and that the same are true and correct. So help me God.

(Signature) F. H. Butcher
Box 7, Ellinwood, Kansas
(Address)

SUBSCRIBED AND SWORN TO before me this 26th day of April, 19 57

My commission expires November 12, 1958

Notary Public.

PLUGGING
FILE SEC. 28 T. 26 R. 12 W
BOOK PAGE 9 LINE 7

FORMATION RECORD

DESCRIBE EACH FORMATION DRILLED. INDICATE THICKNESS, CONTENT AND WHETHER DRY, OR OIL, GAS, OR WATER BEARING.

FORMATION	TOP	BOTTOM	FORMATION	TOP	BOTTOM
Sand, Shale	0	738			
Top Anhydrite	738				
Anhydrite	738	750			
Shale, Shale	750	1200			
Shale, Lime	1200	1960			
Lime	1960	2145			
Lime, Shale	2145	2415			
Lime	2415	3515			
Lime, Shale	3515	3647			
Lime	3647	3703			
Top Lignite	3703				
Lime	3703	4228			
Top Simpson	4228				
Lime	4228	4919			
Top Arbuckle	4919				
Lime, Water w/Very Slight Show of Gas	4919	4959			
San Schlumberger Electric Log to F.D.					
Total Depth					
By Schlumberger		4959			
By Rotary Drill		4959			
Completed as Dry Hole					
Plugged and Abandoned 4-26-57					