

15-151-10606-0000

STATE OF KANSAS
STATE CORPORATION COMMISSION

WELL PLUGGING RECORD

Give All Information Completely
Make Required Affidavit
Mail or Deliver Report to:
Conservation Division
State Corporation Commission
800 Biting Building
Wichita, Kansas

PRATT

County. Sec. 28 Twp. 26S Rge. (E) 12(W)

Location as "NE/CNW/SW" or footage from lines NE NE SE

Lease Owner SHELL OIL COMPANY

Lease Name J. R. COOPER

Well No. 3

Office Address BOX 744, GREAT BEND, KANSAS

Character of Well (completed as Oil, Gas or Dry Hole) DRY HOLE

Date well completed DECEMBER 24 19 52

Application for plugging filed JANUARY 2 19 53

Application for plugging approved DECEMBER 29 19 52


Plugging commenced DECEMBER 27 19 52

Plugging completed DECEMBER 27 19 52

Reason for abandonment of well or producing formation DRY HOLE

If a producing well is abandoned, date of last production - 19 -

Was permission obtained from the Conservation Division or its agents before plugging was commenced? YES

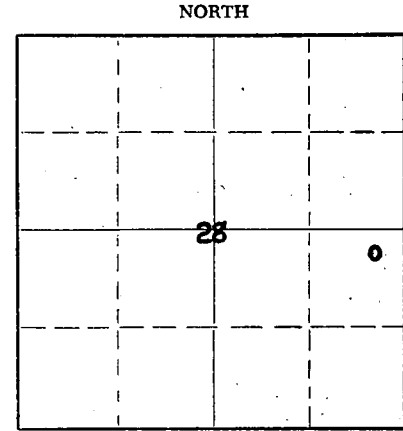

Locate well correctly on above Section Plat

Name of Conservation Agent who supervised plugging of this well M. A. RIVES

Producing formation ARBUCKLE Depth to top 4334 Bottom - Total Depth of Well 4345 Feet

Show depth and thickness of all water, oil and gas formations.

OIL, GAS OR WATER RECORDS

CASING RECORD

FORMATION	CONTENT	FROM	TO	SIZE	PUT IN	PULLED OUT
ARBUCKLE	DRY	4334	4345	10 3/4"	749'	None

Describe in detail the manner in which the well was plugged, indicating where the mud fluid was placed and the method or methods used in introducing it into the hole. If cement or other plugs were used, state the character of same and depth placed, from - feet to - feet for each plug set.

FILLED HOLE WITH HEAVY MUD TO 300'. RAN 1 SACK OF COTTONSEED HULLS; SET HALLIBURTON BOTTOM (WOOD) PLUG AND CAPPED WITH 20 SACK OF CEMENT. FILLED WITH MUD TO 35'. RAN 1 SACK OF COTTONSEED HULLS AND HALLIBURTON BOTTOM PLUG. CEMENTED INTO BOTTOM OF CELLAR WITH 12 SACKS OF CEMENT.

RECEIVED
STATE CORPORATION COMMISSION
1-13-53
JAN 13 1953

Name of Plugging Contractor ADKINS DRILLING COMPANY (If additional description is necessary, use BACK of this sheet)

Address GREAT BEND, KANSAS

STATE OF KANSAS COUNTY OF BARTON, ss.

S. S. MARRY

(employee of owner) or (owner or operator) of the above-described well, being first duly sworn on oath, says: That I have knowledge of the facts, statements, and matters herein contained and the log of the above-described well as filed and that the same are true and correct. So help me God.

(Signature) S. S. Marry

BOX 744, GREAT BEND, KANSAS
(Address)

SUBSCRIBED AND SWORN TO before me this 12th day of JANUARY, 19 53

My commission expires APRIL 11, 1956

L. M. Byers, Jr.
Notary Public.

PLUGGING
FILE SEC 287 26 R 127
BOOK PAGE 69 LINE 2

SHELL J. R. COOPER #3
 NE NE SE 28-26S-12W
 Iuka-Carmi Field
 Pratt County, Kansas

CASING RECORD

10 3/4" cem 749 with 475 sax; cement did not circulate; pumped 50 sax cement in annulus & filled from 40' to surface.

- 0 - 60 sand
- 250 sand & shale
- 410 sand & redbed
- 685 shale & redbed
- 720 sand & shale
- 752 shale & anhydrite
- 1189 sand, shale, redbed
- 1225 shells & sand
- 1480 shale & shells
- 1495 salt & lime
- 1865 shale & shells
- 2909 lime & shale
- 3015 lime, streaks shale, dolomite
- 3029 shale
- 3035 lime
- 3062 shale
- 3120 lime, streaks shale
- 3143 shale
- 3163 sand, slightly shaly
 Top Topeka 3163
- 3221 lime
- 3305 lime, some chert
- 3431 lime
- 3447 shale, v.c.
- 3494 lime
 Top Heebner 3494
- 3500 shale
- 3503 lime
- 3511 shale & lime
 Top Toronto 3511
- 3531 dolomite
- 3545 shale
- 3669 shale, sandy
 Top Brown Lime 3669
- 3676 lime
- 3690 shale & lime
 Top Lansing-Kansas City 3690.
- 3737 lime
- 3740 shale
- 3755 lime
- 3775 lime, argillaceous
- 3788 lime, streaks shale
- 3798 shale
- 3825 lime
- 3837 lime, traces chert

- 4197 lime (driller)
 Top Simpson 4197
- 4234 shale, streaks dolomite & lime (cored)
- 4238 chert & shale
- 4274 lime
- 4334 chert & shale Top Arbuckle 4334
- 4345 dolomite T.D.

ORIGINAL RECORD
 FILED IN 10606-0000
 JAN 6 1953
 DIVISION
 TOPEKA, KANSAS

PLUGGING
 FILE SEC 28 T 26 R 12 W
 BOOK PAGE 69 LINE 2

RECEIVED
 STATE CORPORATION COMMISSION
 JAN 6 1953
 DIVISION
 Topeka, Kansas