

STATE OF KANSAS  
STATE CORPORATION COMMISSION

WELL PLUGGING RECORD

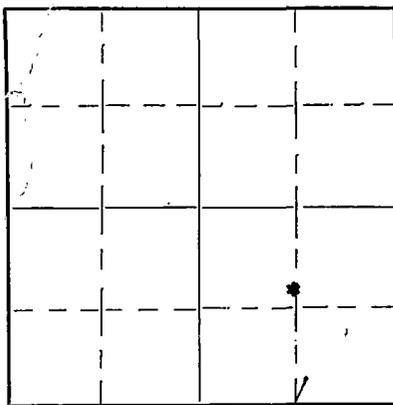
OR

FORMATION PLUGGING RECORD

Strike out upper line when reporting plugging off formations.

Give All Information Completely  
Make Required Affidavit  
Mail or Deliver Report to:  
Conservation Division  
State Corporation Commission  
800 Bittling Building  
Wichita, Kansas

NORTH



Locate well correctly on above Section Plat

Pratt County, Sec. 24 Twp. 27S. Rge. (E) 11 (W)

Location as "NE 1/4 NW 1/4 SW 1/4" or footage from lines. Center. SL N 1/2 SE 1/4

Lease Owner S. A. Springer

Lease Name Staffen Well No. 1

Office Address 806 Union National Bank Bldg., Wichita, Kansas

Character of Well (completed as Oil, Gas or Dry Hole) Dry hole

Date, well completed November 5 19340

Application for plugging filed December 14 19340

Application for plugging approved December 15 19340

Plugging Commenced December 15 19340

Plugging Completed December 20 19340

Reason for abandonment of well or producing formation Dry

If a producing well is abandoned, date of last production 193

Was permission obtained from the Conservation Division or its agents before plugging was commenced? Yes

Name of Conservation Agent who supervised plugging of this well Mr. Alexander

Producing formation Depth to top Bottom Total Depth of Well 4145 Feet

Show depth and thickness of all water, oil and gas formations.

OIL, GAS OR WATER RECORDS

CASING RECORD

| Formation  | Content        | From | To   | Size   | Put In | Pulled Out |
|------------|----------------|------|------|--------|--------|------------|
| lime       | show oil       | 3530 | 3538 | 5 1/2" | 4129   | 2200       |
| viola lime | show gas & HFV | 4128 | 4145 | 10"    | 450    | None       |
|            |                |      |      |        |        |            |
|            |                |      |      |        |        |            |
Describe in detail the manner in which the well was plugged, indicating where the mud fluid was placed and the method or methods used in introducing it into the hole. If cement or other plugs were used, state the character of same and depth placed, from feet to feet for each plug set.

Lower formation plugged with 15 sacks cement and 100 lbs. lead wool to 4139. Hole was plugged with 15 sacks cement and filled with mud to 3550 and then with 15 sacks cement to 3538. Hole was plugged with 9 sacks cement to 3512 and filled with mud to 3350. Pipe was then pulled and hole filled with mud to bottom of surface pipe at 450. Hole was bridged at 450 and cemented with 6 sacks of cement. Hole was bridged 12 ft under bottom of cellar and filled with cement to bottom of cellar. Top of surface pipe was welded over at bottom of cellar.

pd  
1/3/4  
no,

PLUGGING  
FILE 24-27-1111  
BOOK PAGE 122 LINE 28

JAN 3 1940  
STATE CORP. COM.  
CONSERV. DIV.

(If additional description is necessary, use BACK of this sheet)

Correspondence regarding this well should be addressed to S. A. Springer  
Address 806 Union National Bank Building, Wichita, Kansas

STATE OF Kansas, COUNTY OF Sedgwick, ss.

S. A. Springer (owner or operator) of the above-described well, being first duly sworn on oath, says: That I have knowledge of the facts, statements, and matters herein contained and the log of the above-described well as filed and that the same are true and correct. So help me God.

(Signature) S. A. Springer

806 Union National Bank Bldg., Wichita, Kan.  
(Address)

SUBSCRIBED AND SWORN TO before me this 30th day of December, 1940.

My commission expires December 6, 1943

Jane E Macaulay  
Notary Public.

Steffen # 1

Cor. SL N $\frac{1}{2}$  SE $\frac{1}{4}$  Sec. 24-27S-11W  
Pratt County, Kansas

Drilled for: S. A. Springer  
Drilled by: S. A. Springer

Casing Record:

10" 450  
5 $\frac{1}{2}$ " 4129

Drilling commenced: October 7, 1940  
Drilling Completed: November 5, 1940

| <u>FORMATION</u>         | <u>DEPTH</u> | <u>FORMATION</u>          | <u>DEPTH</u> |
|--------------------------|--------------|---------------------------|--------------|
| surface                  | 130          | shale & lime              | 2645         |
| sand & red rock          | 215          | blue shale & lime         | 2690         |
| red rock                 | 380          | shale & lime              | 2840         |
| sand & shells            | 420          | lime 2855                 | 2855         |
| red rock and shale       | 440          | shale & lime              | 2890         |
| red rock                 | 470          | shale                     | 2935         |
| blue shale & gyp         | 750          | lime                      | 3070         |
| shale & gyp shells       | 1005         | sandy lime                | 3155         |
| shale & gyp              | 1180         | lime                      | 3210         |
| salt & shale             | 1315         | lime & shale              | 3245         |
| blue shale & lime shells | 1440         | lime                      | 3310         |
| shale & gyp              | 1630         | lime & shale              | 3360         |
| shale & gyp shells       | 1700         | shale                     | 3480         |
| sticky shale             | 1750         | lime (show oil 3530-3538) | 3565         |
| sandy lime               | 1780         | lime & shale              | 3578         |
| lime                     | 1820         | lime                      | 3675         |
| broken lime              | 1910         | shale & lime              | 3705         |
| shale                    | 1960         | lime                      | 3760         |
| lime & shale             | 1980         | lime & shale              | 3915         |
| shale & lime shells      | 1995         | shale                     | 3935         |
| lime                     | 2085         | cherty lime & shale       | 3965         |
| shale                    | 2140         | shale                     | 4055         |
| lime & shale             | 2200         | shale & lime              | 4065         |
| sticky shale             | 2300         | shale                     | 4114         |
| shale                    | 2350         | shale & shells            | 4128         |
| lime & shale             | 2370         | viola lime                | 4145 T.D.    |
| shale & lime shells      | 2470         |                           |              |
| shale                    | 2560         |                           |              |
| lime                     | 2580         |                           |              |

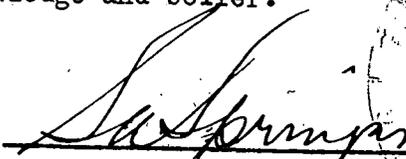
STATE OF KANSAS

SS:

COUNTY OF SEDGWICK

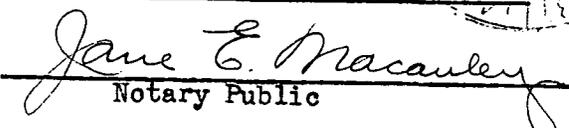
**PLUGGING**  
 FILE E. 24-27-11W  
 BOOK PAGE 122 LINE 28

I, the undersigned, being duly sworn on oath, state that the above and within statement is a true and correct record and log of the well drilled on the location above described, to the best of my knowledge and belief.

  
 S. A. Springer  
 STATE CORP. COMM.  
 CONSERV. DIV.

JAN 3 1941  
 STATE CORP. COMM.  
 CONSERV. DIV.

Subscribed and sworn to before me this 31 day of December, 1940.

  
 Jane E. Macaulley  
 Notary Public

My Commission expires December 6 1943.