

NOTICE OF INTENTION TO DRILL

(see rules on reverse side)

Expected Spud Date... 12/14/87

API Number 15-087-20,399-00-00

OPERATOR: License # 9159

SENECA Sec. 1 Twp. 10 S, Rg. 19 West

Name STERLING EXPLORATION

Address 12101 FROST

City/State/Zip KANSAS CITY 64138

Contact Person JAMES REISE

Phone (816) 737-1026

4420 Ft. from South Line of Section

430 Ft. from East Line of Section

(Note: Locate well on Section Plat on reverse side)

CONTRACTOR: License # 5661

Name Kelly Down Drilling Inc

City/State Neesho Kansas

Nearest lease or unit boundary line 430 feet

County Jefferson

Lease Name Wilman Kimmel Well # 1-87

Ground surface elevation feet MSL

Well Drilled For: Well Class: Type Equipment:

Oil Storage Infield Mud Rotary

Gas Inj Pool Ext Air Rotary

OWWO Expl Wildcat Cable

Domestic well within 330 feet: yes no

Municipal well within one mile: yes no

Depth to bottom of fresh water

Depth to bottom of usable water 275

Surface pipe by Alternate: 1 2

Surface pipe planned to be set 40

Conductor pipe required

Projected Total Depth 1650 feet

Formation Burgess Sand

If OWWO: old well info as follows:

Operator

Well Name

Comp Date Old Total Depth

I certify that well will comply with K.S.A. 55-101, et seq., plus eventually plugging hole to KCC specifications.

Date Signature of Operator or Agent Title Agent

For KCC Use:

Conductor Pipe Required feet; Minimum Surface Pipe Required feet per Alt.

This Authorization Expires 6-15-88 Approved By 12-15-87


EFFECTIVE DATE: 12-20-87

Must be filed with the K.C.C. five (5) days prior to commencing well
 This card void if drilling not started within six (6) months of date received by K.C.C.

Important procedures to follow:

1. Notify District office before setting surface casing.
2. Set surface casing by circulating cement to the top.
3. File completion forms ACO-1 with K.C.C. within 120 days of well spud date, following instructions on ACO-1, side 1, and including copies of wireline logs.
4. Notify District office 48 hours prior to old well workover or re-entry.
5. Prior to filing Intent, prepare a proposed plugging plan in case well is D & A, then obtain approval of plan when calling district office prior to setting surface pipe.
6. Submit plugging report (CP-4) to K.C.C. after plugging is completed.
7. Obtain an approved injection docket number before disposing of salt water.
8. Notify K.C.C. within 10 days when injection commences or terminates.
9. If an alternate 2 completion, cement in the production pipe from below any usable water to surface within 120 days of spud date.

A Regular Section of Land
 1 Mile = 5,280 Ft.

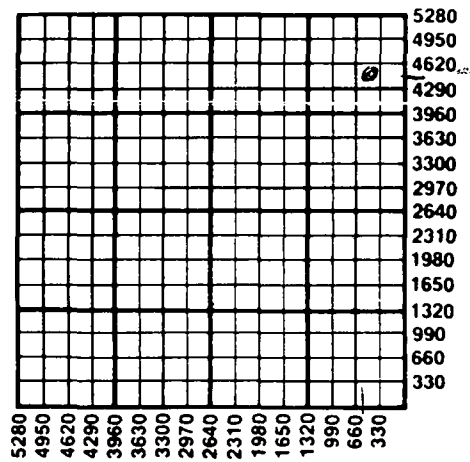

Wichita, Kansas
 STATE CORPORATION COMMISSION OF KANSAS
 Conservation Division
 200 Colorado Derby Building
 Wichita, Kansas 67202-1212
 (316) 263-3238

12-15-87
 RECEIVED
 STATE CORPORATION COMMISSION OF KANSAS
 Conservation Division