

NOTICE OF INTENTION TO DRILL

(see rules on reverse side)

087-20-207 CORRECTION

100-000  
9-30-85

Starting Date Sept. 27, 1985  
month day year

API Number 15-

OPERATOR: License # 4289  
Name Norman R. Hamm  
Address Box 17  
City/State/Zip Perry, KS 66073  
Contact Person Rodney Hamm  
Phone (913) 597-5111

CX NW SW Sec. 1 Twp. 10 S, Rg. 19  
\* 1980 Ft. from South Line of Section  
4620 Ft. from East Line of Section

(Note: Locate well on Section Plat on reverse side)

CONTRACTOR: License # 6792  
Name Caney Valley Drilling, Inc.  
City/State Caney, KS

Nearest lease or unit boundary line 6.60 feet  
County Jefferson

Lease Name Lukens Well # 1

Ground surface elevation na feet MSL

Well Drilled For: Well Class: Type Equipment:  
X Oil SWD Infield X Mud Rotary  
X Gas Inj Pool Ext Air Rotary  
OWWO Expl X Wildcat Cable

Domestic well within 330 feet: yes X no

Municipal well within one mile: yes X no

Surface pipe by Alternate: 1 2 X

If OWWO: old well info as follows:

Depth to bottom of fresh water 2.00 feet

Depth to bottom of usable water 2.75 feet

Surface pipe planned to be set 8.0 feet

Projected Total Depth 17.00 feet

Formation Cherokee Sand

Operator  
Well Name  
Comp Date Old Total Depth

I certify that well will comply with K.S.A. 55-101, et seq., plus eventually plugging hole to KCC specifications.

cementing will be done immediately upon setting production casing.

NW NW  
Kwas  
4620 FSL

Date 9/27/85 Signature of Operator or Agent Title As Agent

For KCC Use:

Conductor Pipe Required feet; Minimum Surface Pipe Required feet per Alt. 1 2

This Authorization Expires 3-26-86 Approved By 9-26-85


Must be filed with the K.C.C. five (5) days prior to commencing well  
 This card void if drilling not started within six (6) months of date received by K.C.C.

**Important procedures to follow:**

**A Regular Section of Land**  
**1 Mile = 5,280 Ft.**

RECEIVED  
 STATE CORPORATION COMMISSION  
 9-27-85  
 SEP 27 1985

CONSERVATION DIVISION  
 Wichita, Kansas

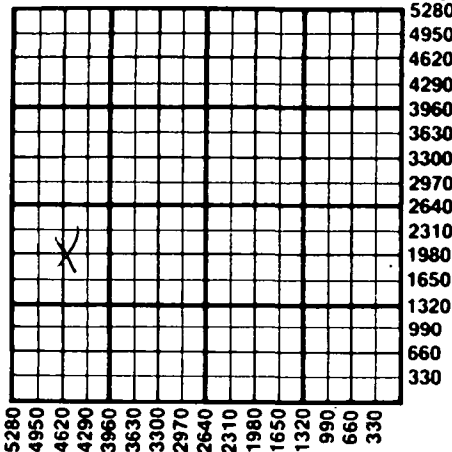

1. Notify District office before setting surface casing.
2. Set surface casing by circulating cement to the top.
3. File completion forms ACO-1 with K.C.C. within 90 days of well completion, following instructions on ACO-1, side 1, and including copies of wireline logs.
4. Notify District office 48 hours prior to old well workover or re-entry.
5. Prior to filing Intent, prepare a proposed plugging plan in case well is D & A, then obtain approval of plan when calling district office prior to setting surface pipe.
6. Submit plugging report (CP-4) to K.C.C. after plugging is completed.
7. Obtain an approved injection docket number before disposing of salt water.
8. Notify K.C.C. within 10 days when injection commences or terminates.
9. If an alternate 2 completion, cement in the production pipe from below any usable water to surface within 120 days of spud date.

State Corporation Commission of Kansas  
 Conservation Division  
 200 Colorado Derby Building  
 Wichita, Kansas 67202  
 (316) 263-3238