

CARD MUST BE TYPED

State of Kansas
NOTICE OF INTENTION TO DRILL
(see rules on reverse side)

CARD MUST BE SIGNED

Starting Date: 9 4 1984
month day year

API Number IS- 087-20, 110-00-00

OPERATOR: License # 5115

SE 1/4 NE NW Sec 1 Twp 10 S, Rge 19 East West
(location)

Name Reese Exploration, Inc.

Address P.O. Box 11598

City/State/Zip Kansas City, MO 64138

Contact Person Bob Lindholm

Phone (816) 356-1970

4620 Ft North from Southeast Corner of Section

2825 Ft West from Southeast Corner of Section

(Note: Locate well on Section Plat on reverse side)

CONTRACTOR: License # 5685

Nearest lease or unit boundary line 990 feet.

County Jefferson

Name Michael Drilling, Inc.

Lease Name J. Kimmel Well# 2-84

City/State Humboldt, KS 66748

Domestic well within 330 feet: yes no

Municipal well within one mile: yes no

Well Drilled For: Well Class: Type Equipment:

- | | | | |
|---|-------------------------------|---|--|
| <input checked="" type="checkbox"/> Oil | <input type="checkbox"/> Swd | <input type="checkbox"/> Infield | <input checked="" type="checkbox"/> Mud Rotary |
| <input checked="" type="checkbox"/> Gas | <input type="checkbox"/> Inj | <input type="checkbox"/> Pool Ext. | <input type="checkbox"/> Air Rotary |
| <input type="checkbox"/> OWWO | <input type="checkbox"/> Expl | <input checked="" type="checkbox"/> Wildcat | <input type="checkbox"/> Cable |

If OWWO: old well info as follows:

Operator

Well Name

Comp Date Old Total Depth

Projected Total Depth Mississippian feet

Projected Formation at TD Cherokee Sand

Expected Producing Formations

Depth to Bottom of fresh water 20 feet

Lowest usable water formation

Depth to Bottom of usable water 200 225 feet

Surface pipe by Alternate: 1 2

Surface pipe to be set 40 feet

Conductor pipe if any required

Ground surface elevation feet MSL

This Authorization Expires 3-1-85

Approved By 8-29-84

I certify that we will comply with K.S.A. 55-101, et seq., plus eventually plugging hole to K.C.C. specifications.

Date 8/29/1984 Signature of Operator or Agent

Roxie Robles Title As. Agent

MK/KDHE 8/29/84
Form C-1 4/84


Must be filed with the K.C.C. five (5) days prior to commencing well
 This card void if drilling not started within six (6) months of date received by K.C.C.

RECEIVED
 STATE CORPORATION COMMISSION

8-29-84
 AUG 29 1984

Important procedures to follow:

A Regular Section of Land
1 Mile = 5,280 Ft.

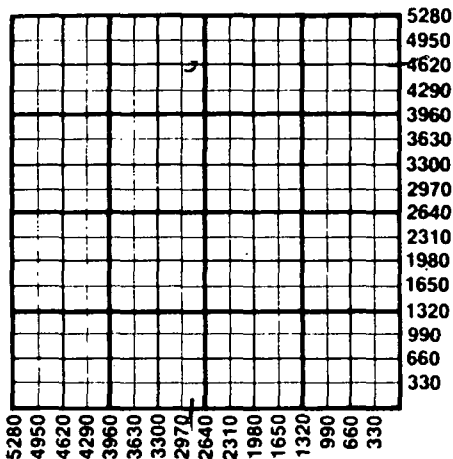

1. Notify District office before setting surface casing
2. Set surface casing by circulating cement to the top.
3. File completion forms ACO-1 with K.C.C. within 90 days of well completion, following instructions on ACO-1, side 1, and including copies of wireline logs.
4. Notify District office 48 hours prior to old well workover or re-entry.
5. Prior to plugging, prepare a plugging plan, then obtain agreement from the appropriate district office for an approved plugging plan.
6. Submit plugging report (CP-4) to K.C.C. after plugging is completed.
7. Obtain an approved injection docket number before disposing of salt water.
8. Notify K.C.C. within 10 days when injection commences or terminates.
9. If an alternate 2 completion, cement in the production pipe from below any usable water to surface within 120 days of spud date.

CONSERVATION DIVISION
 Wichita, Kansas

State Corporation Commission of Kansas
 Conservation Division
 200 Colorado Derby Building
 Wichita, Kansas 67202
 (316) 263-3238