

CARD MUST BE TYPED

State of Kansas
NOTICE OF INTENTION TO DRILL 10-31-84 CARD MUST BE SIGNED
(see rules on reverse side)

SPOT LOCATION CORRECTION

Starting Date: 10 31 84
month day year

API Number IS- 007-21,957-0000

OPERATOR: License # 5701
Name National Oil Company
Address Box 272
City/State/Zip Russell, Kansas 67665
Contact Person Larry W. Sutherland
Phone 913-483-6278

* C N/2. SE NW Sec. 22. Twp. 30. S, Rge. 13
(location)
* 3630 Ft North from Southeast Corner of Section
3300 Ft West from Southeast Corner of Section
(Note: Locate well on Section Plat on reverse side)

East
 West

CONTRACTOR: License # 5671
Name Revlin Drlg., Inc.
City/State Box 293 Russell, Ks. 67665

Nearest lease or unit boundary line 330 feet.
County Barber
Lease Name Grigsby Well# 4
Domestic well within 330 feet: yes no
Municipal well within one mile: yes no

Well Drilled For: Well Class: Type Equipment:
 Oil Swd Infield Mud Rotary
 Gas Inj Pool Ext. Air Rotary
 OWWO Expl Wildcat Cable

Depth to Bottom of fresh water 200 feet
Lowest usable water formation Permian
Depth to Bottom of usable water 200 feet
Surface pipe by Alternate: 1 2
Surface pipe to be set 320 feet
Conductor pipe if any required feet
Ground surface elevation feet MSL
This Authorization Expires 4-29-85
Approved By 10-29-84

If OWWO: old well info as follows:

Operator
Well Name
Comp Date Old Total Depth
Projected Total Depth 4700' feet
Projected Formation at TD Arbuckle
Expected Producing Formations


I certify that we will comply with K.S.A. 55-101, et seq., plus eventually plugging hole to K.C.C. specifications. *was: CSE NW 3300 FSL*

Date 10-30-84 Signature of Operator or Agent *Paula J. Sibson* Title Agent

Must be filed with the K.C.C. five (5) days prior to commencing well
 This card void if drilling not started within six (6) months of date received by K.C.C.

Important procedures to follow :

A Regular Section of Land
1 Mile = 5,280 Ft.

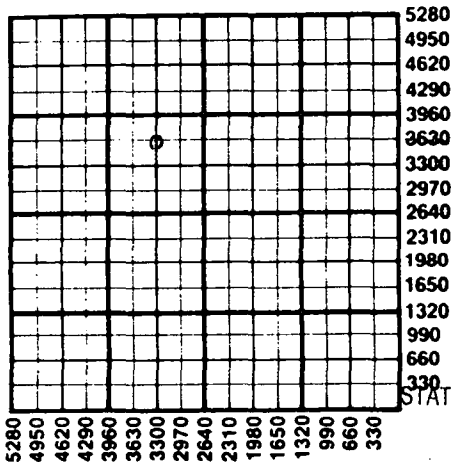

1. Notify District office before setting surface casing.
2. Set surface casing by circulating cement to the top.
3. File completion forms ACO-1 with K.C.C. within 90 days of well completion, following instructions on ACO-1, side 1, and including copies of wireline logs.
4. Notify District office 48 hours prior to old well workover or re-entry.
5. Prior to plugging, prepare a plugging plan, then obtain agreement from the appropriate district office for an approved plugging plan.
6. Submit plugging report (CP-4) to K.C.C. after plugging is completed.
7. Obtain an approved injection docket number before disposing of salt water.
8. Notify K.C.C. within 10 days when injection commences or terminates.

RECEIVED alternate 2 completion, cement in the production pipe from below
 STATE CORPORATION COMMISSION any usable water to surface within 120 days of spud date.

OCT 31 1984
10-31-84
 CONSERVATION DIVISION
 Wichita, Kansas

State Corporation Commission of Kansas
 Conservation Division
 200 Colorado Derby Building
 Wichita, Kansas 67202
 (316) 263-3238