

CARD MUST BE TYPED

State of Kansas
NOTICE OF INTENTION TO DRILL

CARD MUST BE SIGNED

(see rules on reverse side)

Starting Date: November 11 1985
month day year

API Number 15- 151-21,740-00-00
NW NW NE East
210'E. Sec 3... Twp 27. S, Rge 12.. West
(location)

OPERATOR: License # ~~9514~~ 9514
Name D & D Productions, Inc.
Address 403 S. Main, Box 321
City/State/Zip Pratt, KS 67124
Contact Person Darrel Anderson
Phone 316-672-5002

.. 4950..... Ft North from Southeast Corner of Section
.. 2100..... Ft West from Southeast Corner of Section
(Note: Locate well on Section Plat on reverse side)

CONTRACTOR: License # Lobo Drilling Co., 5864
Name Lobo Drilling Co.
City/State Great Bend, KS

Nearest lease or unit boundary line 330..... feet.
County Pratt
Lease Name Lathrop Well# A-4
Domestic well within 330 feet: yes no
Municipal well within one mile: yes no

Well Drilled For: Well Class: Type Equipment:
 Oil Swd Infield Mud Rotary
 Gas Inj Pool Ext. Air Rotary
 OWWO Expl Wildcat Cable

Depth to Bottom of fresh water 235..... feet
Lowest usable water formation
Depth to Bottom of usable water 235..... feet
Surface pipe by Alternate: 1 2
Surface pipe to be set 300..... feet
Conductor pipe if any required none..... feet
Ground surface elevation 1891..... feet MSL
This Authorization Expires 5-4-86
Approved By 11-4-85

If OWWO: old well info as follows:
Operator
Well Name
Comp Date Old Total Depth
Projected Total Depth 4400..... feet
Projected Formation at TD Viola
Expected Producing Formations Mississippi

I certify that we will comply with K.S.A. 55-101, et seq., plus eventually plugging hole to K.C.C. specifications.


Date 11-1-85 Signature of Operator or Agent Darrel Anderson President
Darrel Anderson Title

REPT/ONE

Must be filed with the K.C.C. five (5) days prior to commencing well
This card void if drilling not started within six (6) months of date received by K.C.C.

Important procedures to follow :

**A Regular Section of Land
1 Mile = 5,280 Ft.**

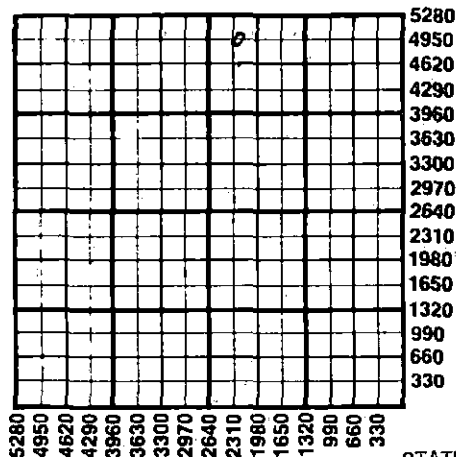

1. Notify District office before setting surface casing.
2. Set surface casing by circulating cement to the top.
3. File completion forms ACO-1 with K.C.C. within 90 days of well completion, following instructions on ACO-1, side 1, and including copies of wireline logs.
4. Notify District office 48 hours prior to old well workover or re-entry.
5. Prior to plugging, prepare a plugging plan, then obtain agreement from the appropriate district office for an approved plugging plan.
6. Submit plugging report (CP-4) to K.C.C. after plugging is completed.
7. Obtain an approved injection docket number before disposing of salt water.
8. Notify K.C.C. within 10 days when injection commences or terminates.
9. If an alternate 2 completion, cement in the production pipe from below any usable water to surface within 120 days of spud date.

RECEIVED

STATE CORPORATION COMMISSION

NOV 4 1950

CONSERVATION DIVISION
Wichita, Kansas

State Corporation Commission of Kansas

Conservation Division
200 Colorado Derby Building
Wichita, Kansas 67202
(316) 263-3238