

NOTICE OF INTENTION TO DRILL

(see rules on reverse side)

Starting Date 9-8-86 month day year

API Number 15-151-21,802-00-00
Approx. Cof S 1/2-NE-NW Sec. 3... Twp. 27.. S, Rg. 12... East West
4120 Ft. from South Line of Section
3300 Ft. from East Line of Section

OPERATOR: License # 9514
Name D & D Production, Inc.
Address 403 S. Main, P.O. Box 321
City/State/Zip Pratt, KS 67124
Contact Person Darrel Anderson
Phone (316)672-5002

(Note: Locate well on Section Plat on reverse side)

Nearest lease or unit boundary line 1140 feet
County Pratt
Lease Name Lathrop Well # A-7

CONTRACTOR: License # 5929
Name Duke Drilling Co., Inc.
City/State Great Bend, KS 67530

Ground surface elevation 1899 feet MSL
Domestic well within 330 feet: yes no
Municipal well within one mile: yes no

Well Drilled For: Well Class: Type Equipment:
X Oil SWD X Infield X Mud Rotary
Gas Inj Pool Ext Air Rotary
OWWO Expl Wildcat Cable

Depth to bottom of fresh water 235'
Depth to bottom of usable water 295'
Surface pipe by Alternate: 1 X 2
Surface pipe planned to be set 300'
Conductor pipe required N/A
Projected Total Depth 4500 feet
Formation Viola

If OWWO: old well info as follows:
Operator
Well Name
Comp Date Old Total Depth

I certify that well will comply with K.S.A. 55-101, et seq., plus eventually plugging hole to KCC specifications
Date 8-19-86 Signature of Operator or Agent Darrel Anderson Title President

For KCC Use:
Conductor Pipe Required feet; Minimum Surface Pipe Required 240 feet per Alt 1
This Authorization Expires 2-20-87 Approved By 8-20-86


Handwritten signature and initials

Must be filed with the K.C.C. five (5) days prior to commencing well  
This card void if drilling not started within six (6) months of date received by K.C.C.

**Important procedures to follow:**

1. Notify District office before setting surface casing.
2. Set surface casing by circulating cement to the top.
3. File completion forms ACO-1 with K.C.C. within 90 days of well completion, following instructions on ACO-1, side 1, and including copies of wireline logs.
4. Notify District office 48 hours prior to old well workover or re-entry.
5. Prior to filing Intent, prepare a proposed plugging plan in case well is D & A, then obtain approval of plan when calling district office prior to setting surface pipe.
6. Submit plugging report (CP-4) to K.C.C. after plugging is completed.
7. Obtain an approved injection docket number before disposing of salt water.
8. Notify K.C.C. within 10 days when injection commences or terminates.
9. If an alternate 2 completion, cement in the production pipe from below any usable water to surface within 120 days of spud date.

**A Regular Section of Land  
1 Mile = 5,280 Ft.**

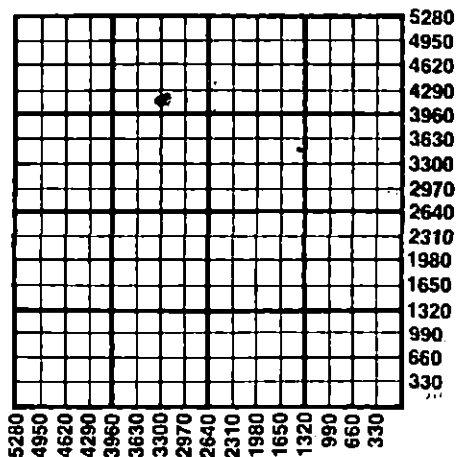

AUG 20 1988

State Corporation Commission of Kansas  
Conservation Division  
200 Colorado Derby Building  
Wichita, Kansas 67202  
(316) 263-3238