

CARD MUST BE TYPED

State of Kansas  
**NOTICE OF INTENTION TO DRILL**

CARD MUST BE SIGNED

(see rules on reverse side)

Starting Date: July 10, 1985  
month day year 1985

API Number 15-151-21,649-00-00

OPERATOR: License # 9415  
Name D & D Production, Inc.  
Address Box 321, 403 S. Main  
City/State/Zip Pratt, Ks. 67124  
Contact Person Darrel Anderson  
Phone (316)672-5002

NE-NW of Sec 3... Twp 27. S, Rge 12W West  
(location)  
4580 Ft North from Southeast Corner of Section  
3250 Ft West from Southeast Corner of Section  
(Note: Locate well on Section Plat on reverse slide)

CONTRACTOR: License # 5149  
Name Wheatstate Drilling & Well Serv.  
City/State Pratt, Ks.

Nearest lease or unit boundary line 700' feet.  
County Pratt  
Lease Name Lathrop Well# A-3

Well Drilled For: Well Class: Type Equipment:  
 Oil  Swd  Infield  Mud Rotary  
 Gas  Inj  Pool Ext.  Air Rotary  
 OWWO  Expl  Wildcat  Cable

Domestic well within 330 feet:  yes  no  
Municipal well within one mile:  yes  no

If OWWO: old well info as follows:  
Operator  
Well Name  
Comp Date Old Total Depth  
Projected Total Depth 4700 feet  
Projected Formation at TD Arbuckle  
Expected Producing Formations Lansing-KC-Mississippi

Depth to Bottom of fresh water 215 feet  
Lowest usable water formation  
Depth to Bottom of usable water 235 feet  
Surface pipe by Alternate:  2   
Surface pipe to be set 300 feet  
Conductor pipe if any required none feet  
Ground surface elevation 1898 feet MSL  
This Authorization Expires 1-8-86  
Approved By 7-2-85 [Signature]

I certify that we will comply with K.S.A. 55-101, et seq., plus eventually plugging hole to K.C.C. specifications.

rch for KOHE

Date 7-5-85 Signature of Operator or Agent

[Signature] Title President

Must be filed with the K.C.C. five (5) days prior to commencing well  
This card void if drilling not started within six (6) months of date received by K.C.C.

RECEIVED  
STATE CORPORATION COMMISSION


Important procedures to follow:

A Regular Section of Land  
1 Mile = 5,280 Ft.

08 1985

CONSERVATION DIVISION

Wichita, Kansas

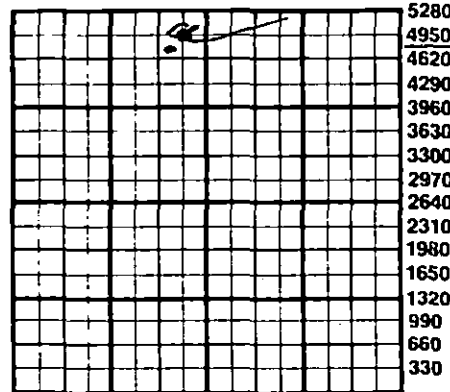

5280  
4950  
4620  
4290  
3960  
3630  
3300  
2970  
2640  
2310  
1980  
1650  
1320  
990  
660  
330

1. Notify District office before setting surface casing.
2. Set surface casing by circulating cement to the top.
3. File completion forms ACO-1 with K.C.C. within 90 days of well completion, following instructions on ACO-1, side 1, and including copies of wireline logs.
4. Notify District office 48 hours prior to old well workover or re-entry.
5. Prior to plugging, prepare a plugging plan, then obtain agreement from the appropriate district office for an approved plugging plan.
6. Submit plugging report (CP-4) to K.C.C. after plugging is completed.
7. Obtain an approved injection docket number before disposing of salt water.
8. Notify K.C.C. within 10 days when injection commences or terminates.
9. If an alternate 2 completion, cement in the production pipe from below any usable water to surface within 120 days of spud date.

State Corporation Commission of Kansas  
Conservation Division  
200 Colorado Derby Building  
Wichita, Kansas 67202  
(316) 263-3238