

CARD MUST BE TYPED

State of Kansas
NOTICE OF INTENTION TO DRILL

CARD MUST BE SIGNED

(see rules on reverse side)

CORRECTED LOCATION

Starting Date: July 1 1985
month day year

API Number 15-151-21,635-0000

OPERATOR: License # 5003

* SW SW SE (location) Sec 22 Twp 26 S, Rge 12 East West

Name McCoy Petroleum Corporation

Address 110 S. Main, Suite 500

City/State/Zip Wichita, Kansas 67202

Contact Person Roger McCoy

Phone (316) 265-9697

CONTRACTOR: License # 5658

Name Sweetman Drilling, Inc.

City/State Wichita, Kansas 67202

* 330 Ft North from Southeast Corner of Section
2310 Ft West from Southeast Corner of Section
(Note: Locate well on Section Plat on reverse side)

Nearest lease or unit boundary line 330 feet.

County Pratt

Lease Name Strong "B" Well# 1

Domestic well within 330 feet: yes no

Municipal well within one mile: yes no

Well Drilled For: Well Class: Type Equipment:

Oil Swd Infield Mud Rotary

Gas Inj Pool Ext. Air Rotary

OWWO Expl Wildcat Cable

Depth to Bottom of fresh water 200 feet

Lowest usable water formation Top of Permian

Depth to Bottom of usable water 250 feet

Surface pipe by Alternate: 1 2

Surface pipe to be set 250 feet

Conductor pipe if any required None

Ground surface elevation 1900 (estimate) feet MSL

If OWWO: old well info as follows:

This Authorization Expires 12-25-85

Approved By RCH 7-23-85 ORIL RCV 6-25-85

* WAS: SE SW SW 4290' FEL

Operator

Well Name

Comp Date 4400 Old Total Depth

Projected Total Depth 4400 feet

Projected Formation at TD Arbuckle

Expected Producing Formations L-KC, Simpson, Arbuckle

I certify that we will comply with K.S.A. 55-101, et seq., plus eventually plugging hole to K.C.C. specifications.


Date 7-22-85 Signature of Operator or Agent

Roger McCoy President

CORRECTED

RECEIVED
 STATE CORPORATION COMMISSION **Must be filed with the K.C.C. five (5) days prior to commencing well**
This card void if drilling not started within six (6) months of date received by K.C.C.

JUL 27
 7-23-85
 CONSERVATION DIVISION
 Wichita, Kansas
A Regular Section of Land
1 Mile = 5,280 Ft.

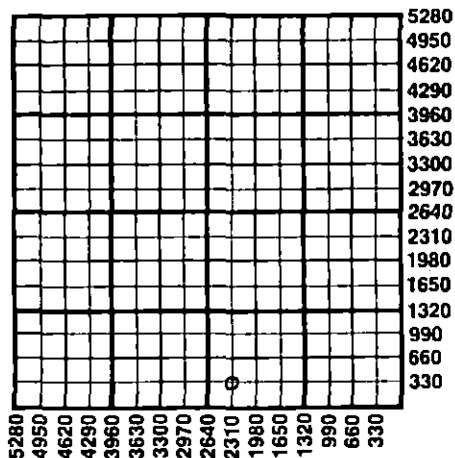

Important procedures to follow :

1. Notify District office before setting surface casing.
2. Set surface casing by circulating cement to the top.
3. File completion forms ACO-1 with K.C.C. within 90 days of well completion, following instructions on ACO-1, side 1, and including copies of wireline logs.
4. Notify District office 48 hours prior to old well workover or re-entry.
5. Prior to plugging, prepare a plugging plan, then obtain agreement from the appropriate district office for an approved plugging plan.
6. Submit plugging report (CP-4) to K.C.C. after plugging is completed.
7. Obtain an approved injection docket number before disposing of salt water.
8. Notify K.C.C. within 10 days when injection commences or terminates.
9. If an alternate 2 completion, cement in the production pipe from below any usable water to surface within 120 days of spud date.

State Corporation Commission of Kansas
Conservation Division
200 Colorado Derby Building
Wichita, Kansas 67202
(316) 263-3238