FORM MUST BE TYPED
FORM C-1 12/88

State of Kansas
NOTICE OF INTENTION TO DRILL
Must be approved by the K.C.C. five (5) days prior to commencing well

FORM MUST BE SIGNED
ALL BLANKS MUST BE FILLED

Expected Spud Date: September 2, 1989 (month day year)

NE SE NE Sec 26 Twp 26 S, Rg 12 — East X West

3630 feet from South line of Section
~~1650~~ 330' feet from East line of Section
(Note: Locate well on Section Plat Below)

OPERATOR: License # 3180
Name: DEUTSCH OIL COMPANY
Address: 107 N. Market - Suite 1115
City/State/Zip: Wichita, Kansas 67202
Contact Person: Kent Deutsch
Phone: 316/267-7551

CONTRACTOR: License #: 5929
Name: DUKE DRILLING CO., INC.

County: Pratt
Lease Name: Allen "B" Well #: 1-26
Field Name: Stead South Ext.
Is this a Prorated Field? .... yes X no
Target Formation(s): Mississippi, Kinderhook
Nearest lease or unit boundary: 330
Ground Surface Elevation: N/A feet MSL
Domestic well within 330 feet: .... yes X no
Municipal well within one mile: .... yes X no
Depth to bottom of fresh water: 200'
Depth to bottom of usable water: 220'
Surface Pipe by Alternate: X 1 2
Length of Surface Pipe Planned to be set: 240'+
Length of Conductor pipe required: N/A
Projected Total Depth: 4300'
Formation at Total Depth: Kinderhook
Water Source for Drilling Operations:
X well .... farm pond .... other
DWR Permit #:
Will Cores Be Taken? .... yes X no
If yes, proposed zone:

Well Drilled For:		Well Class:	Type Equipment:
X Oil	... Inj	X Infield	X Mud Rotary
... Gas	... Storage	... Pool Ext.	... Air Rotary
... OWWO	... Disposal	... Wildcat	... Cable
... Seismic;	... # of Holes		

If OWWO: old well information as follows:
Operator:
Well Name:
Comp. Date: ..... Old Total Depth .....

Directional, Deviated or Horizontal wellbore? .... yes X no
If yes, total depth location:

AFFIDAVIT

The undersigned hereby affirms that the drilling, completion and eventual plugging of this well will comply with K.S.A. 55-101, et. seq.
It is agreed that the following minimum requirements will be met:

1. The appropriate district office shall be notified before setting surface pipe;
2. The minimum amount of surface pipe as specified above shall be set by circulating cement to the top; in all cases surface pipe shall be set through all unconsolidated materials plus a minimum of 20 feet into the underlying formation;
3. If the well is dry, a plugging proposal shall be submitted to the district office. An agreement between the operator and the district office on plug length and placement is necessary prior to plugging;
4. The appropriate district office will be notified before well is either plugged or production casing is cemented in;
5. If an Alternate II completion, production pipe shall be cemented from below any usable water to surface within 120 days of spud date. In all cases, notify district office prior to any cementing.

I hereby certify that the statements made herein are true and to the best of my knowledge and belief.

Date: August 30, 1989 Signature of Operator or Agent: [signature] Title: Owner

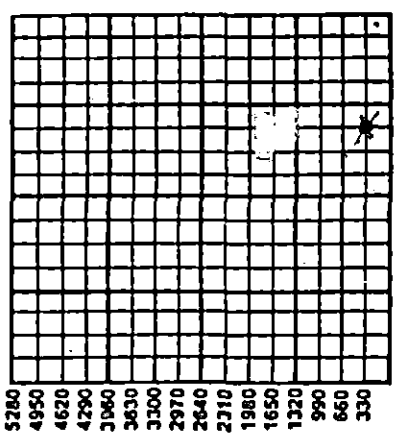

RECEIVED
STATE CORPORATION COMMISSION
SEP 11 1989
CONSERVATION DIVISION
Wichita, Kansas

FOR KCC USE:
API # 15- 151-21,946-0000
Conductor pipe required NONE feet
Minimum surface pipe required 240' feet per Alt. (1) X
Approved by: DPW 9-11-89
EFFECTIVE DATE: 9-16-89
This authorization expires:
(This authorization void if drilling not started within 6 months of effective date.)
Spud date: _____ Agent: _____

26 26 12W

REMEMBER TO:

- File Drill Pit Application (form CDP-1) with Intent to Drill;
- File Completion Form ACO-1 within 120 days of spud date;
- File acreage attribution plat according to field proration orders;
- Notify appropriate district office 48 hours prior to workover or re-entry;
- Submit plugging report (CP-4) after plugging is completed;
- Obtain written approval before disposing or injecting salt water.

Mail to: Conservation Division, 200 Colorado Derby Building, 202 W. First St., Wichita, Kansas 67202-1286.