

CARD MUST BE TYPED

State of Kansas

CARD MUST BE SIGNED

NOTICE OF INTENTION TO DRILL

Bill Eaton

(see rules on reverse side)

Starting Date April 22, 1986
month day year

API Number 15- 151-21-787-0000 42286

OPERATOR: License # 7543

NW SE SE Sec. 26 Twp. 26 S, Rg 12 East XX West
990 Ft. from South Line of Section
990 Ft. from East Line of Section

Name Woods Petroleum Corporation
Address Box 947
City/State/Zip Pratt, Kansas 67124
Contact Person Brian G. Fisher
Phone 316-263-4777

(Note: Locate well on Section Plat on reverse side)

Nearest lease or unit boundary line 990 feet
County Pratt
Lease Name Mardis "C" Well # 1-26

CONTRACTOR: License # 5380

Ground surface elevation feet MSL
Domestic well within 330 feet: yes XX no
Municipal well within one mile: yes XX no

Name Eagle Drilling, Inc.
City/State P.O. Box 8690, Wichita, KS 67208

Well Drilled For: Well Class: Type Equipment:
XX Oil SWD Infield XX Mud Rotary
Gas Inj XX Pool Ext Air Rotary
OWWO Expl Wildcat Cable

Depth to bottom of fresh water 250'
Depth to bottom of usable water 300'
Surface pipe by Alternate: XX 2

If OWWO: old well info as follows:

Surface pipe planned to be set 350'
Conductor pipe required
Projected Total Depth 4450' feet
Formation Simpson Sand

Operator
Well Name
Comp Date Old Total Depth

I certify that well will comply with K.S.A. 55-101, et seq., plus eventually plugging hole to KCC specifications.

Date 4/22/86 Signature of Operator or Agent *T. Juan B. Fisher* Title DISTRICT GEOLOGIST

For KCC Use:

Conductor Pipe Required 250 feet; Minimum Surface Pipe Required 10-18-86 feet per Alt. 17
This Authorization Expires 4-18-86 Approved By


Wichita Address

Must be filed with the K.C.C. five (5) days prior to commencing well
This card void if drilling not started within six (6) months of date received by K.C.C.

Important procedures to follow:

1. Notify District office before setting surface casing.
2. Set surface casing by circulating cement to the top.
3. File completion forms ACO-1 with K.C.C. within 90 days of well completion, following instructions on ACO-1, side 1, and including copies of wireline logs.
4. Notify District office 48 hours prior to old well workover or re-entry.
5. Prior to filing Intent, prepare a proposed plugging plan in case well is D & A, then obtain approval of plan when calling district office prior to setting surface pipe.
6. Submit plugging report (CP-4) to K.C.C. after plugging is completed.
7. Obtain an approved injection docket number before disposing of salt water.
8. Notify K.C.C. within 10 days when injection commences or terminates.
9. If an alternate 2 completion, cement in the production pipe from any usable water to surface within 120 days of spud date.

A Regular Section of Land
1 Mile = 5,280 Ft.

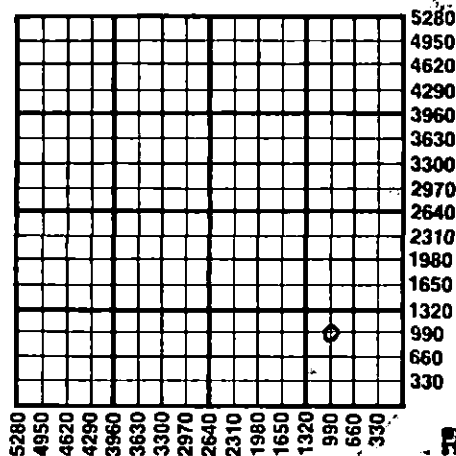

RECEIVED
STATE CORPORATION COMMISSION

APR 22 1986
4-22-86
CONSERVATION DIVISION
Wichita, Kansas

State Corporation Commission of Kansas
Conservation Division
200 Colorado Derby Building
Wichita, Kansas 67202
(316) 263-3238