

CARD MUST BE TYPED

State of Kansas

CARD MUST BE SIGNED

NOTICE OF INTENTION TO DRILL

CORRECTION

6-9-87

(see rules on reverse side)

Expected Spud Date... June 15, 1987 month day year

API Number 15- 151-21,841-00-00

OPERATOR: License # 3180
Name DEUTSCH OIL COMPANY
Address 107 North Market - Suite 1008
City/State/Zip Wichita, Kansas 67202
Contact Person Kent Deutsch
Phone 316/267-7551

N/2 NE SW Sec. 26 Twp. 27 S, Rg. 11
2310 Ft. from South Line of Section
3300 Ft. from East Line of Section

(Note: Locate well on Section Plat on reverse side)

CONTRACTOR: License # 5929
Name DUKE DIRLLING CO. INC.
City/State Great Bend, Kansas 67530

Nearest lease or unit boundary line 330 feet
County Pratt
Lease Name SITTON Well # 1

Well Drilled For: Well Class: Type Equipment:
X Oil Storage X Infield X Mud Rotary
Gas Inj Pool Ext Air Rotary
OWWO Expl Wildcat Cable

Ground surface elevation feet MSL
Domestic well within 330 feet yes X no
Municipal well within one mile yes X no
Depth to bottom of fresh water 130
Depth to bottom of usable water 225
Surface pipe by Alternate 1 X 2

If OWWO: old well info as follows:

Surface pipe planned to be set 300
Conductor pipe required
Projected Total Depth 4500 feet
Formation Arbuckle

I certify that well will comply with K.S.A. 55-101, et seq. plus eventually plugging hole to KCC specifications.

Date June 9, 1987 Signature of Operator or Agent Sally R. Byers Title Agent

For KCC Use:

Conductor Pipe Required feet; Minimum Surface Pipe Required 300 feet per Alt. 20

This Authorization Expires 12-4-87 Approved By 6-4-87


***WAS: N/2 NE SE 3300 FEL

Must be filed with the K.C.C. five (5) days prior to commencing well
This card void if drilling not started within six (6) months of date received by K.C.C.

Important procedures to follow:

1. Notify District office before setting surface casing.
2. Set surface casing by circulating cement to the top.
3. File completion forms ACO-1 with K.C.C. within 120 days of well spud date, following instructions on ACO-1, side 1, and including copies of wireline logs.
4. Notify District office 48 hours prior to old well workover or re-entry.
5. Prior to filing Intent, prepare a proposed plugging plan in case well is D & A, then obtain approval of plan when calling district office prior to setting surface pipe.
6. Submit plugging report (CP-4) to K.C.C. after plugging is completed.
7. Obtain an approved injection docket number before disposing of salt water.
8. Notify K.C.C. within 10 days when injection commences or terminates.
9. If an alternate 2 completion, cement in the production pipe from below any usable water to surface within 120 days of spud date.

A Regular Section of Land
1 Mile = 5,280 Ft.

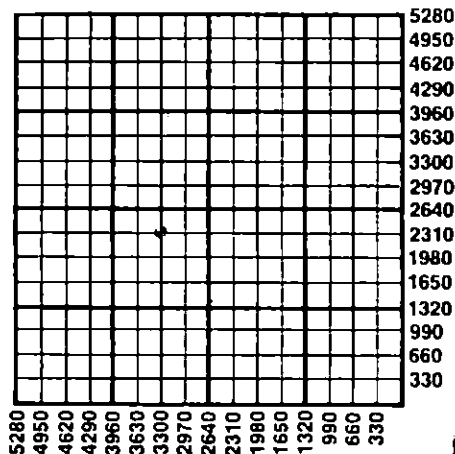

RECEIVED
STATE COMMISSION

JUN 9 1971

CONSERVATION DIVISION
Wichita, Kansas

State Corporation Commission of Kansas
Conservation Division
200 Colorado Derby Building
Wichita, Kansas 67202-1212
(316) 263-3238