

CARD MUST BE TYPED

State of Kansas
NOTICE OF INTENTION TO DRILL
(see rules on reverse side)

CARD MUST BE SIGNED

Starting Date: 3 11 85
month day year

API Number 15- 151-21,582-0000

OPERATOR: License # 5313
Name F & M OIL CO., INC.
Address 422 Union Center
City/State/Zip Wichita, Kansas 67202
Contact Person Debra FitzGerald
Phone (316)262-2636

NW NE NW Sec 18 Twp 26 S, Rge 12W East
(location) West

4950 Ft North from Southeast Corner of Section
3630 Ft West from Southeast Corner of Section
(Note: Locate well on Section Plat on reverse side)

CONTRACTOR: License # 5103
Name Union Drilling Co., Inc.
City/State Wichita, Kansas 67202

Nearest lease or unit boundary line .330 feet.
County Pratt
Lease Name Schiewe "B" Well# 1
Domestic well within 330 feet: yes no
Municipal well within one mile: yes no

Well Drilled For: Well Class: Type Equipment:
 Oil Swd Infield Mud Rotary
 Gas Inj Pool Ext. Air Rotary
 OWWO Expl Wildcat Cable

Depth to Bottom of fresh water 150 feet
Lowest usable water formation Top Permian
Depth to Bottom of usable water 300-250 feet
Surface pipe by Alternate: 1 2
Surface pipe to be set 275 feet
Conductor pipe if any required ----- feet
Ground surface elevation ----- feet MSL
This Authorization Expires 8-28-85
Approved By 2-28-85

If OWWO: old well info as follows:

Operator -----
Well Name -----
Comp Date ----- Old Total Depth -----
Projected Total Depth 4465' feet
Projected Formation at TD Arbuckle
Expected Producing Formations Lans/KC

I certify that we will comply with K.S.A. 55-101, et seq., plus eventually plugging hole to K.C.C. specifications.

Date 2-28-85 Signature of Operator or Agent


Vice-President

Must be filed with the K.C.C. five (5) days prior to commencing well
 This card void if drilling not started within six (6) months of date received by K.C.C.

Wichita, Kansas
 CONSERVATION DIVISION
 FEB 28 1985

Important procedures to follow:

A **Section of Land**
 STATE CORPORATION COMMISSION
 RECEIVED
 1 Mile

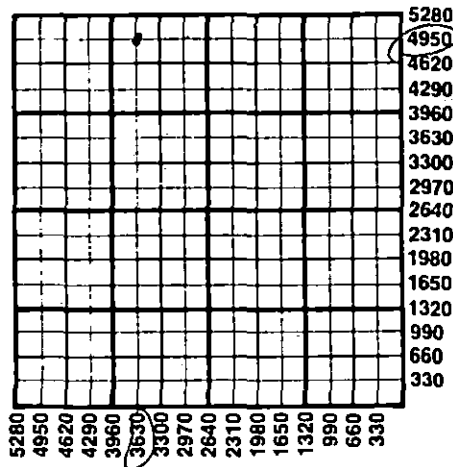

1. Notify District office before setting surface casing.
2. Set surface casing by circulating cement to the top.
3. File completion forms ACO-1 with K.C.C. within 90 days of well completion, following instructions on ACO-1, side 1, and including copies of wireline logs.
4. Notify District office 48 hours prior to old well workover or re-entry.
5. Prior to plugging, prepare a plugging plan, then obtain agreement from the appropriate district office for an approved plugging plan.
6. Submit plugging report (CP-4) to K.C.C. after plugging is completed.
7. Obtain an approved injection docket number before disposing of salt water.
8. Notify K.C.C. within 10 days when injection commences or terminates.
9. If an alternate 2 completion, cement in the production pipe from below any usable water to surface within 120 days of spud date.

1920
 1720
 11/20

State Corporation Commission of Kansas
 Conservation Division
 200 Colorado Derby Building
 Wichita, Kansas 67202
 (316) 263-3238