

This form shall be filed in duplicate with the Kansas Corporation Commission, 200 Colorado Derby Building, Wichita, Kansas 67202, within ten days after the completion of the well, regardless of how the well was completed.

Attach separate letter of request if the information is to be held confidential. If confidential, only file one copy. Information on side one will be of public record and side two will then be held confidential.

Circle one: Oil, Gas, Dry, SWD, OWWO, Injection. Type and complete ALL sections. Applications must be filed for dual completion, commingling, SWD and injection, T.A. Attach wireline logs (i.e. electrical log, sonic log, gamma ray neutron log, etc.). KCC # (316) 263-3238. (Rules 82-2-105 & 82-2-125)

OPERATOR Eagle Explorations, Inc.

API NO. 15-151-20978-0000

ADDRESS 107 N. Market, Suite 300

COUNTY Pratt

Wichita, Kansas 67202

FIELD Wildcat (STARK)

**CONTACT PERSON D. R. Ramsay

PROD. FORMATION Viola

PHONE 265-2897

LEASE Coulter

PURCHASER

WELL NO. #1

ADDRESS

WELL LOCATION C SE-SE-NE

DRILLING Sarcee Drilling

2310 Ft. from North Line and

CONTRACTOR

330 Ft. from East Line of

ADDRESS 1800 Kansas

the NE/4 SEC. 12 TWP. 26S RGE. 12W


Great Bend, Kansas 67530

WELL PLAT

PLUGGING

CONTRACTOR

ADDRESS

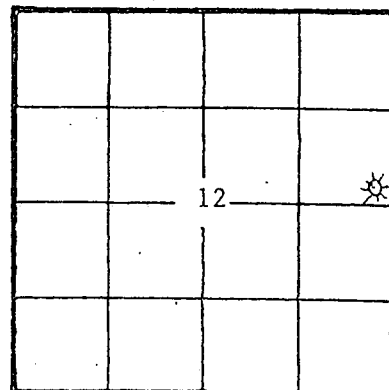

KCC [check] KGS [check] (Office Use)

TOTAL DEPTH 4373' PBSD 4331 (Est.)

SPUD DATE 1981-08-04 DATE COMPLETED 1981-08-16

ELEV: GR 1857 DF 1869 KB 1871

DRILLED WITH (CABLE) (ROTARY) (AIR) TOOLS

Amount of surface pipe set and cemented 402' DV Tool Used? No

AFFIDAVIT

STATE OF Kansas, COUNTY OF Pratt SS, I,

D. R. Ramsay OF LAWFUL AGE, BEING FIRST DULY SWORN UPON HIS OATH,

DEPOSES THAT HE IS Drilling Superintendent (FOR)(OF) Eagle Explorations, Inc.


OPERATOR OF THE Coulter LEASE, AND IS DULY AUTHORIZED TO MAKE

THIS AFFIDAVIT FOR AND ON THE BEHALF OF SAID OPERATOR, THAT WELL NO. #1 ON

SAID LEASE HAS BEEN COMPLETED AS OF THE 16th DAY OF August, 1981, AND THAT

ALL INFORMATION ENTERED HEREIN IS TRUE AND CORRECT.

FURTHER AFFIANT SAITH NOT.

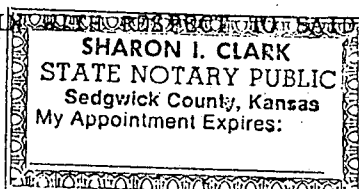

(S) D. R. Ramsay

SUBSCRIBED AND SWORN BEFORE ME THIS 7th DAY OF April, 1982.

Sharon I. Clark

NOTARY PUBLIC Sharon I. Clark

MY COMMISSION EXPIRES: March 16, 1983

**The person who can be reached by phone regarding any questions concerning this information. Within 45 days of completion, a witnessed initial test by the Commission is required if the well produces more than 25 BOPD or is located in a Basic Order Pool.