

This form shall be filed in duplicate with the Kansas Corporation Commission, 200 Colorado Derby Building, Wichita, Kansas 67202, within ten days after the completion of the well, regardless of how the well was completed.

Attach separate letter of request if the information is to be held confidential. If confidential, only file one copy. Information on side one will be of public record and side two will then be held confidential.

Circle one: Oil, Gas, Dry, SWD, OWWO, Injection. Type and complete ALL sections. Applications must be filed for dual completion, commingling, SWD and injection, T.A.

Attach wireline logs (i.e. electrical log, sonic log, gamma ray neutron log, etc.). KCC # (316) 263-3238. (Rules 82-2-105 & 82-2-125)

OPERATOR W. L. KIRKMAN, INC.

API NO. 15-151-21,028 -0000

ADDRESS 453 So. Webb Road, P.O. Box 18611

COUNTY PRATT

Wichita, Kansas 67207

FIELD LELA

**CONTACT PERSON WAYNE L. KIRKMAN

PROD. FORMATION Marmaton

PHONE (316) 685-5372

LEASE BRIGGEMAN

PURCHASER

WELL NO. 1-B

ADDRESS

WELL LOCATION SE-SE-NW

DRILLING SWEETMAN DRILLING

2310 Ft. from North Line and

CONTRACTOR

2310 Ft. from West Line of


ADDRESS One Main Place - Suite 410

the NW/4 SEC. 23 TWP. 26S RGE. 12W

Wichita, Kansas 67202

WELL PLAT

PLUGGING

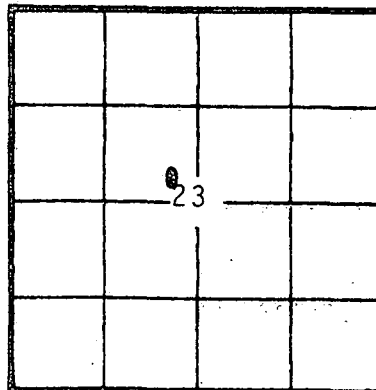

CONTRACTOR

KCC KGS (Office Use)

ADDRESS

TOTAL DEPTH 4390 PBDT 4285

SPUD DATE 10-17-81 DATE COMPLETED 10-27-81

ELEV: GR 1875 DF ----- KB 1884

DRILLED WITH (CABLE) ROTARY (AIR) TOOLS

Amount of surface pipe set and cemented 8 5/8 @ 454' DV Tool Used? YES

AFFIDAVIT

STATE OF KANSAS, COUNTY OF SEDGWICK

RECEIVED STATE CORPORATION COMMISSION 1-8-82 1082 CONSERVATION DIVISION Wichita, Kansas

KIRBY C. EVERS OF LAWFUL AGE, BEING FIRST DULY SWORN

DEPOSES THAT HE IS VICE-PRESIDENT (FOR)(OF) W. L. KIRKMAN, INC.

OPERATOR OF THE BRIGGEMAN LEASE, AND IS DULY AUTHORIZED TO MAKE

THIS AFFIDAVIT FOR AND ON THE BEHALF OF SAID OPERATOR, THAT WELL NO. 1-B ON

SAID LEASE HAS BEEN COMPLETED AS OF THE 7th DAY OF January, 19 82, AND THAT

ALL INFORMATION ENTERED HEREIN WITH RESPECT TO SAID WELL IS TRUE AND CORRECT.

FURTHER AFFIANT SAITH NOT.

(s) Kirby C. Evers, Vice-President

SUBSCRIBED AND SWORN BEFORE ME THIS 7th DAY OF January, 19 82.

Kathleen G. Quinn

MY COMMISSION EXPIRES: March 20, 1983

NOTARY PUBLIC KATHLEEN G. QUINN

**The person who can be reached by phone regarding any questions concerning this information. Within 45 days of completion, a witnessed initial test by the Commission is required if the well produces more than 25 BOPD or is located in a Basic Order Pool.

