

STATE OF KANSAS
STATE CORPORATION COMMISSION


Form CP-4

Give All Information Completely
Make Required Affidavit
Mail or Deliver Report to:
Conservation Division
State Corporation Commission
212 No. Market
Wichita, Kansas 67202

WELL PLUGGING RECORD

Barber County, Sec. 27 Twp. 32S Rge. 15 (W)

Location as "NE/CNW/SW" or footage from lines Ctr S/2 SE SE
Lease Owner Champlin Petroleum Company
Lease Name Baird Well No. 4
Office Address P. O. Box 308, Ellinwood, Kansas
Character of Well (completed as Oil, Gas or Dry Hole) Oil
Date well completed October 4 19 48
Application for plugging filed September 7 19 71
Application for plugging approved September 8 19 71
Plugging commenced October 18 19 71
Plugging completed October 21 19 71
Reason for abandonment of well or producing formation SWDW - No longer takes salt water

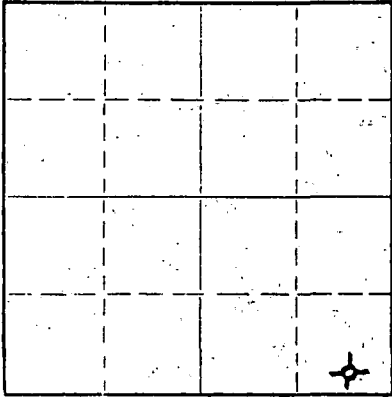

Locate well correctly on above Section Plat

If a producing well is abandoned, date of last production 19
Was permission obtained from the Conservation Division or its agents before plugging was commenced? Yes

Name of Conservation Agent who supervised plugging of this well G. Russell Biberstein
Producing formation Depth to top Bottom Total Depth of Well 4946 Feet
Show depth and thickness of all water, oil and gas formations.

OIL, GAS OR WATER RECORDS

CASING RECORD

FORMATION	CONTENT	FROM	TO	SIZE	PUT IN	PULLED OUT
				8 5/8" OD	795'	None
				5 1/2" OD	4945'	3092'

Describe in detail the manner in which the well was plugged, indicating where the mud fluid was placed and the method or methods used in introducing it into the hole. If cement or other plugs were used, state the character of same and depth placed, from feet to feet for each plug set.

Filled with sand from 4946' to 4900' and run 5 sacks of cement to 4870' filled with sand to 260' and set 10' rock bridge to 250' and ran 4 yards of Ready Mix cement filling to bottom of cellar.

RECEIVED
STATE CORPORATION COMMISSION
10-27-71
OCT 27 1971
CONSERVATION DIVISION
Wichita, Kansas


Name of Plugging Contractor Glenn & Smith Casing Pulling Company
Address Ellinwood, Kansas 67526

STATE OF Kansas, COUNTY OF Barton, ss.
J. W. Meyers (employee of owner) or (operator) of the above-described

well, being first duly sworn on oath, says: That I have knowledge of the facts, statements, and matters herein contained and the log of the above-described well as filed and that the same are true and correct. So help me God.

(Signature): J. W. Meyers, District Operations Manager
P. O. Box 308, Ellinwood, Kansas 67526
(Address)

Subscribed and sworn to before me this 25th day of October, 1971

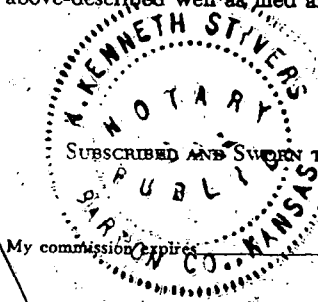

N. Kenneth Stivers Notary Public.

My commission expires 4/16/74

15-007-01368-00-01

CHAMPLIN PETROLEUM COMPANY

WELL #4

Sec. 27 - T 32S - R 15W
Located 330' FSL and 560' FSL
Barber County, Kansas

RECEIVED
STATE CORPORATION COMMISSION
9-8-71
SEP 8 1971
CONSERVATION DIVISION
Wichita, Kansas

CASING RECORD:

8 5/8" - 320' Used - 795' cemented w/ 300 sz.
5 1/2" - 140' O.D. New & Used - 4953' cemented w/ 250 sz.

FORMATION RECORD:

0' - 500'	Redbed and Shells
500' - 700'	Sand, Shale and Shells
700' - 795'	Redbed and Shells
795' - 1,255'	Redbed and Salt
1,255' - 1,450'	Salt and Shells
1,450' - 1,865'	Shale and Shells
1,865' - 1,895'	Anhydrite
1,895' - 2,012'	Shale and Shells
2,012' - 3,040'	Lime and Shale
3,040' - 3,165'	Shale and Shells
3,165' - 4,915'	Shale and Lime
4,915' - 4,946'	Lime
4,946'	TOTAL DEPTH

FORMATION TOPS:

4,178' (-2,294')	Top, Lansing
4,730' (-2,846')	Top, Ercosial Miss.
4,912' (-3,023')	Top, Maquoketa Dolomite
4,926' (-3,042')	Top, Viola, Coarsly Crystalline Lime