


STATE OF KANSAS
STATE CORPORATION COMMISSION

WELL PLUGGING RECORD

Give All Information Completely
Make Required Affidavit
Mail or Deliver Report to
Conservation Division
State Corporation Comm.
245 North Water
Wichita, KS 67202

Barber County, Sec. 27 Twp. 32S Rge. 15W E/W
Location as "NE/CNW $\frac{1}{4}$ SW $\frac{1}{4}$ " or footage from lines
C SW NW

Lease Owner Assoc. Petr. Consult. & Presley Oil Company
Lease Name Marsh Ranch Well No. #1-27
Office Address Suite 600 - One Main Place, Wichita, KS
Character of Well (Completed as Oil, Gas or Dry Hole)
Dry Hole

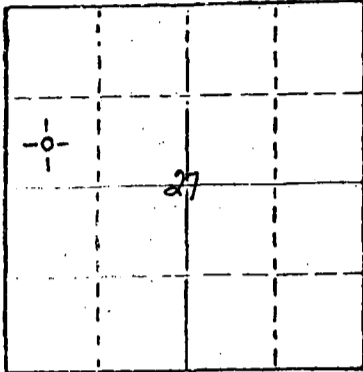

Locate well correctly on above
Section Plot

Date Well completed April 28, 1982
Application for plugging filed April 28, 1982
Application for plugging approved April 28, 1982
Plugging commenced 10:00 a.m. 19
Plugging completed 12:15 p.m. 19

Reason for abandonment of well or producing formation
D & A
If a producing well is abandoned, date of last production
None 19

Was permission obtained from the Conservation Division or
its agents before plugging was commenced? yes

Name of Conservation Agent who supervised plugging of this well Maurice Leslie
Producing formation X Depth to top X Bottom X Total Depth of Well 5260'
Show depth and thickness of all water, oil and gas formations.

OIL, GAS OR WATER RECORDS				CASING RECORD		
FORMATION	CONTENT	FROM	TO	SIZE	PUT IN	PULLED OUT
				8 5/8"	330'	none

Describe in detail the manner in which the well was plugged, indicating where the mud fluid was placed and the method or methods used in introducing it into the hold. If cement or other plugs were used, state the character of same and depth placed, from _____ feet to _____ feet for each plug set.

- Ran 60 sacks @ 650'
- 40 sacks @ 320'
- 10 sacks @ 40' w/1/2 sack hulls & wooden bridge plug.
- 10 sacks Rat Hole
- 5 sacks Mouse Hole

RECEIVED
STATE CORPORATION COMMISSION

MAY 10 1982
5-10-82

(If additional description is necessary, use BACK of this form)
Name of Plugging Contractor Heartland Drilling, Inc. Conservation Division
Wichita, Kansas

STATE OF KANSAS COUNTY OF SEDGWICK, ss.
Phyllis Buchanan (employee of owner) or (owner or operator)
of the above-described well, being first duly sworn on oath, says: That I have knowledge of the facts, statements, and matters herein contained and the log of the above-described well as filed and that the same are true and correct. So help me God.

(Signature) Phyllis Buchanan
PHYLLIS BUCHANAN
(Address)

SUBSCRIBED AND SWORN TO before me this 3rd day of May, 1982

My commission expires 6-29-85

Sherry Wayman
SHERRY WAYMAN Notary Public.

