

15-165-30086-0000

STATE OF KANSAS
STATE CORPORATION COMMISSION
GIVE THIS INFORMATION COMPLETELY


WELL PLUGGING RECORD

Make Required Affidavit
Mail or Deliver Report to:
Conservation Division
State Corporation Commission
211 No. Broadway
Wichita, Kansas

1965

10-27-65

CONSERVATION DIVISION

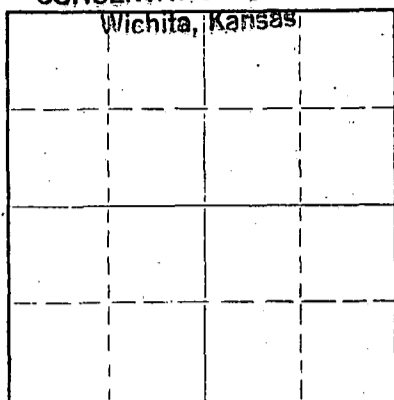

Locate well correctly on above Section Plat

Rush County. Sec. 13 Twp. 18S Rge. 16W (E) (W)
Location as "NE/CNW/SW" or footage from lines c SE NE
Lease Owner E K Edmiston and Sidwell Oil and Gas, Inc.
Lease Name RIEDL Well No. 1
Office Address 425 First National Bank Bldg., Wichita, Ks.
Character of Well (completed as Oil, Gas or Dry Hole) dry hole
Date well completed October 12, 1965 19
Application for plugging filed October 12, 1965 19
Application for plugging approved October 12, 1965 19
Plugging commenced October 12, 1965 19
Plugging completed October 12, 1965 19
Reason for abandonment of well or producing formation dry hole

If a producing well is abandoned, date of last production 19
Was permission obtained from the Conservation Division or its agents before plugging was commenced? yes

Name of Conservation Agent who supervised plugging of this well Eldon Petty
Producing formation --- Depth to top --- Bottom --- Total Depth of Well 3476' Feet
Show depth and thickness of all water, oil and gas formations.

OIL, GAS OR WATER RECORDS

CASING RECORD

FORMATION	CONTENT	FRDM	TD	SIZE	PUT IN	PULLED OUT
				8-5/8"	963'	---

Describe in detail the manner in which the well was plugged, indicating where the mud fluid was placed and the method or methods used in introducing it into the hole. If cement or other plugs were used, state the character of same and depth placed, from --- feet to --- feet for each plug set.


plug and 1/2 sack hulls and 20 sacks cement at 420';
plug and 1/4 sack hulls and 20 sacks cement at 180';
top plug and 1/4 sack hulls and 10 sacks cement at 40';
completed at 6:15 a.m. on October 12, 1965.

(If additional description is necessary, use BACK of this sheet)

Name of Plugging Contractor E. K. Edmiston Drilling Co., Inc.
Address 425 First National Bank Building, Wichita, Kansas

STATE OF KANSAS, COUNTY OF SEDGWICK, ss.
E. K. Edmiston, operator, ~~operator~~ of the above-described well, being first duly sworn on oath, says: That I have knowledge of the facts, statements, and matters herein contained and the log of the above-described well as filed and that the same are true and correct. So help me God.

(Signature) E. K. Edmiston
425 First National Bank Building, Wichita
(Address) _____ Ks.

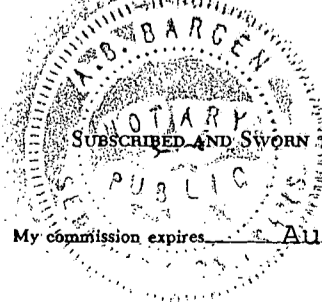

Subscribed and Sworn to before me this 26th day of October, 1965
A. B. BARGEN Notary Public.

My commission expires August 25, 1968

RECEIVED
STATE CORPORATION COMMISSION

10-27-65
OCT 27 1965

Company:
CONSERVATION DIVISION
Wichita, Kansas

DRILLER'S LOG

E. K. Edmiston and Sidwell Oil and Gas, Inc.
425 First National Bank Building
Wichita, Kansas 67202

Rotary Drilling Commenced: October 2, 1965

Rotary Drilling Completed: October 12, 1965

Well Name: RIEDL No. 1
c. SE NE 13-18S-16W
Rush County, Kansas

Contractor: E. K. Edmiston Drilling Co., Inc.
425 First National Bank Building
Wichita, Kansas 67202

Casing Record: 963' of 8-5/8" with 450 sacks cement


L O G

Measurements from top of rotary bushing

Sand	0 - 129
Surface hole (sand at 380')	510
Red Bed and Shale	955
Anhydrite	980
Shale	1232
Shale and Shells	1740
Shale and Lime	1870
Lime and Shale	2244
Shale and Lime	2382
Shale and Lime (broken)	2520
Lime and Shale	2870
Lime	3076
Lime and Shale	3338
Lime	3422
Lime and Shale	3445
Conglomerate, Shale and Lime	3469
Sand and Lime	3476 RTD

The undersigned, E. K. Edmiston, President of E. K. Edmiston Drilling Co., Inc., hereby certifies on behalf of said company that the above log is a true and correct log of the formations encountered in drilling the above well, as reflected by the daily drilling reports.

E. K. EDMISTON DRILLING CO., INC.

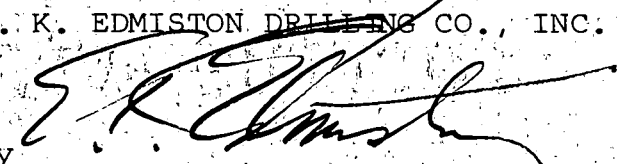By 
E. K. Edmiston, President


STATE OF KANSAS,

SS:

SEDGWICK COUNTY,

BE IT REMEMBERED that on this 26th day of October, 1965, before me, the undersigned, a Notary Public within and for the county and state aforesaid, came E. K. Edmiston, known to me to be the same person who executed the foregoing instrument as President and on behalf of the E. K. Edmiston Drilling Co., Inc., and he duly acknowledged the execution of the same for himself and for said company.

IN WITNESS WHEREOF, I have hereunto set my hand and official seal on the day and year last above written.


A. B. Bargen, Notary Public

My commission expires August 25, 1968