


STATE OF KANSAS
STATE CORPORATION COMMISSION

Form CP-4

WELL PLUGGING RECORD

Give All Information Completely
Make Required Affidavit
Mail or Deliver Report to:
Conservation Division
State Corporation Commission
212 No. Market
Wichita, Kansas 67202

NORTH

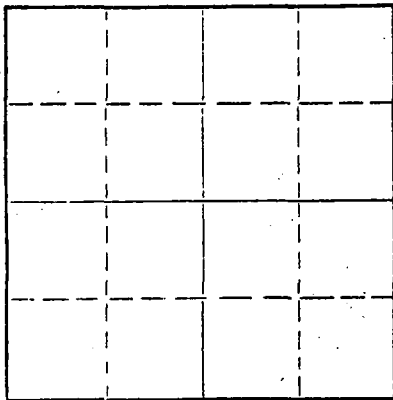

Locate well correctly on above
Section Plat

Rush County. Sec 13 Twp. 18 Rge. 16 (E) W (W)
Location as "NE/CNWxSWx" or footage from lines 250' E of C NW NW
Lease Owner Braden Drilling, Inc.
Lease Name Mohr "A" Well No# 1
Office Address 1620 Vickers KSB & T Bldg.; Wichita, Ks. 67202
Character of Well (completed as Oil, Gas or Dry Hole) _____
Date well completed _____ 19 ____
Application for plugging filed May 19 71
Application for plugging approved May 19 71
Plugging commenced May 5 19 71
Plugging completed May 6 19 71
Reason for abandonment of well or producing formation _____

If a producing well is abandoned, date of last production _____ 19 ____
Was permission obtained from the Conservation Division or its agents before plugging was commenced? Yes

Name of Conservation Agent who supervised plugging of this well Leo Massey
Producing formation _____ Depth to top _____ Bottom _____ Total Depth of Well 2990 Feet
Show depth and thickness of all water, oil and gas formations.

OIL, GAS OR WATER RECORDS

CASING RECORD

FORMATION	CONTENT	FROM	TO	SIZE	PUT IN	PULLED OUT
				8 5/8	243	None
				5 1/2	2460	None

Describe in detail the manner in which the well was plugged, indicating where the mud fluid was placed and the method or methods used in introducing it into the hole. If cement or other plugs were used, state the character of same and depth placed, from _____ feet to _____ feet for each plug set.

May 5, 1971 Plugged off bottom. Dumped sand to 1800'. Mixed and dumped 5 sx of cement to 1760'.

May 6, 1971 Plugged off top. 5 1/2" casing was cemented in from approximately 1800' to surface. Set rock bridge in 5 1/2" casing at 350'. Filled 5 1/2" casing with 3000 lb. PSI ready mix concrete, from 350' to base of cellar.

RECEIVED
STATE CORPORATION COMMISSION
JUN 10 1971
CONSERVATION DIVISION
Wichita, Kansas

Name of Plugging Contractor RUSS CASING PULLING, INC.
Address P. O. Box 1082 Great Bend, Kansas 67530

STATE OF Kansas, COUNTY OF Sedgwick, ss.
Jack Hardy (employee of owner) or (owner or operator) of the above-described

well, being first duly sworn on oath, says: That I have knowledge of the facts, statements, and matters herein contained and the log of the above-described well as filed and that the same are true and correct. So help me God.

(Signature) Jack Hardy
1620 Vickers-KSB&T Bldg., Wichita, Ks.
(Address)

Subscribed and sworn to before me this 9th day of June, 1971

My commission expires January 19, 1974

Marilyn Ann Smith
Marilyn Ann Smith, Notary Public.

