

15-207-00286-0000

STATE OF KANSAS
STATE CORPORATION COMMISSION

WELL PLUGGING RECORD


OR

FORMATION PLUGGING RECORD

Strike out upper line
when reporting plug-
ging of formations.

Give All Information Completely
Make Required Affidavit
Mail or Deliver Report to:
Conservation Division
State Corporation Commission
800 Bittling Building
Wichita, Kansas

NORTH

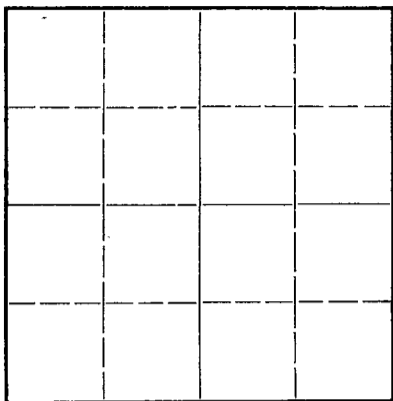

Locate well correctly on above
Section Plat

Barber County, Sec 22 Twp 30 Rge (E) 13 (W)
Location as "NE1/4NW1/4SW1/4" or footage from lines SW/4 SW/4 SE/4
Lease Owner Lion Oil Company
Lease Name Odell Well No 1
Office Address Box 552, Pratt, Kansas
Character of Well (completed as Oil, Gas or Dry Hole) Dry Hole
Date well completed 4-19-45 19
Application for plugging filed 7-6-45 19
Application for plugging approved 7-6-45 19
Plugging commenced 7-6-45 19
Plugging completed 7-8-45 19
Reason for abandonment of well or producing formation Dry hole

If a producing well is abandoned, date of last production 19
Was permission obtained from the Conservation Division or its agents before plugging was com-
menced? Yes

Name of Conservation Agent who supervised plugging of this well Mr. Herb Kerr
Producing formation None Depth to top - Bottom - Total Depth of Well 4694 Feet
Show depth and thickness of all water, oil and gas formations.

OIL, GAS OR WATER RECORDS

CASING RECORD

| Formation | Content | From | To | Size | Put In | Pulled Out |
|-----------|---------|------|----|------|--------|------------|
| | | | | | | |
| | | | | | | |
Describe in detail the manner in which the well was plugged, indicating where the mud fluid was placed and the method or methods used in introducing it into the hold. If cement or other plugs were used, state the character of same and depth placed, from feet to feet for each plug set.
Filled hole with heavy mud from bottom to 580 feet. Placed bridging plug at 550 feet. Cemented with 15 sacks of cement. Set another bridging plug at 30 feet. Used 10 sacks of cement.

PLUGGING
FILE 22 20R 13W
BOOK PAGE 21-LINE 38

(If additional description is necessary, use BACK of this sheet)

Correspondence regarding this well should be addressed to Mr. Vernon Hayes
Address P. O. Box 552
Pratt, Kansas

STATE OF Kansas, COUNTY OF Pratt, ss.

(employee of owner) or (owner or operator) of the above-described well,
being first duly sworn on oath, says: That I have knowledge of the facts, statements, and matters herein contained and the log of the above-described well as filed and that the same are true and correct. So help me God.

(Signature) *Vernon Hayes*
Box 552, Pratt, Kansas

SUBSCRIBED AND SWORN to before me this 13 day of August 1945
Notary Public. *Mabel Condit*



commission expires July 1-1946

Lion Oil Refining Company
El Dorado, Arkansas

Odell Well No. 1

SE corner SW/4 SE/4
Sec. 22-30S-13W
Barber County, Kansas

Contractor: The R. W. Rine Drilling Company
Commenced: March 25, 1945

Completed: May 3, 1945

LOG

| | |
|---------------------|-----------|
| Sand | 0-110 |
| Redbed | 110-290 |
| Shale | 290-400 |
| Sand | 400-430 |
| Shale | 430-555 |
| Redbed | 555-790 |
| Shale & Shells | 790-1795 |
| Shale & Lime | 1795-2090 |
| Lime | 2090-2175 |
| Lime & Shale | 2175-2550 |
| Shale | 2550-2645 |
| Shale & Lime | 2645-2985 |
| Lime | 2985-3120 |
| Lime & Shale | 3120-3210 |
| Shale & Shells | 3210-3415 |
| Lime & Shale Breaks | 3415-3490 |
| Lime | 3490-3760 |
| Lime & Shale | 3760-3940 |
| Lime | 3940-4233 |
| Lime & Shale | 4233-4403 |
| Shale | 4403-4429 |
| Chert & Lime | 4429-4451 |
| Lime & Shale | 4451-4469 |
| Shale | 4469-4500 |
| Lime & Shale | 4500-4561 |
| Lime | 4561-4639 |
| Lime & Shale | 4639-4685 |
| Lime | 4685-4689 |
| Sand | 4689-4694 |

8 5/8" casing cemented @ 580'

5 1/2" casing cemented @ 4694'
Total Depth 4694'

State of Kansas)
County of Barton) ss

I, Clyde W. Goddard, do hereby certify that the above is a true and complete log of the Odell Well No. 1, located in the SE corner of the SW/4 of the SE/4, Section 22, Township 30S, Range 13W, Barber County, Kansas.

Clyde W. Goddard

Sworn to and subscribed before me this 7th day of May, 1945

PLUGGING
FILE NO. 22-30R13W
BOOK PAGE 2-1 LINE 38

STATE OF KANSAS
AUG 1 1945
DIVISION
8-14-45
My commission expires Dec. 6, 1948