

STATE OF KANSAS  
STATE CORPORATION COMMISSION


WELL PLUGGING RECORD

Give All Information Completely  
Make Required Affidavit  
Mail or Deliver Report to:  
Conservation Division  
State Corporation Commission  
800 Bittling Building  
Wichita, Kansas

Pratt County. Sec. 21 Twp. 26 Rge. 12 (E) W (W)

Location as "NE/CNW $\frac{1}{4}$ SW $\frac{1}{4}$ " or footage from lines SW SW SW  
Lease Owner Ben F. Brack Oil Company, Inc.  
Lease Name Knop Well No. 1  
Office Address 309-10 Brown Building, Wichita, Kansas  
Character of Well (completed as Oil, Gas or Dry Hole) Dry hole  
Date well completed January 26, 1951 19  
Application for plugging filed February 28, 1951 19  
Application for plugging approved February 28, 1951 19  
Plugging commenced February 28, 1951 19  
Plugging completed February 28, 1951 19  
Reason for abandonment of well or producing formation Nothing there

NORTH

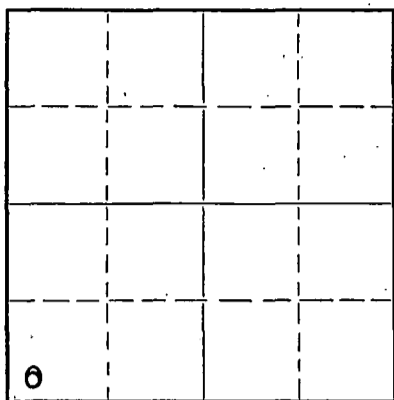

Locate well correctly on above  
Section Plat

If a producing well is abandoned, date of last production - - - 19

Was permission obtained from the Conservation Division or its agents before plugging was commenced? Yes - verbally

Name of Conservation Agent who supervised plugging of this well C. D. Stough

Producing formation Arbuckle Depth to top 4321 Bottom Total Depth of Well 4326 Feet

Show depth and thickness of all water, oil and gas formations.

OIL, GAS OR WATER RECORDS

CASING RECORD

Formation	Content	From	To	Size	Put In	Pulled Out
Surface - Red Beds		0	321	8-5/8"	321	0
Arbuckle		0	4322	5-1/2"	4322	2650'

Describe in detail the manner in which the well was plugged, indicating where the mud fluid was placed and the method or methods used in introducing it into the hole. If cement or other plugs were used, state the character of same and depth placed, from 320 feet to 25 feet for each plug set.

Filled hole with heavy mud to 320'. Set plug with 15 sacks of cement. Second plug set at 25' with 5 sacks of cement. Filled hole and leveled location.

RECEIVED  
STATE CORPORATION COMMISSION  
MAR - 8 1951  
CONSERVATION DIVISION  
Wichita, Kansas

(If additional description is necessary, use BACK of this sheet)

Correspondence regarding this well should be addressed to Ben F. Brack Oil Company, Inc.  
Address 309-10 Brown Building, Wichita 2, Kansas

STATE OF Kansas, COUNTY OF Sedgwick, ss.  
Emil E. Bowers (employee of owner) or (owner or operator) of the above-described well,

being first duly sworn on oath, says: That I have knowledge of the facts, statements, and matters herein contained and the log of the above-described well as filed and that the same are true and correct. So help me God.

(Signature) BEN F. BRACK OIL COMPANY, INC.  
Emil E. Bowers  
309-10 Brown Building, Wichita 2, Ks.  
(Address)

SUBSCRIBED AND SWORN to before me this 6th day of March 1951

Yelda R. Evans  
Notary Public.

My commission expires November 1, 1954

PLUGGING  
FILE SEC 21 T 26 R 12  
PAGE 65 LINE 7

BEN F. BRACK OIL COMPANY, INC.  
 309-10 BROWN BUILDING  
 WICHITA 2, KANSAS

KNOPP #1

SW SW SW

Sec. 21 Twp. 26 Rg 12W  
 Pratt County, Kansas

Commenced: January 2, 1951  
 TOTAL DEPTH: 4326

Completed: January 26, 1951

WELL LOG

Cellar	5'
Red Bed	318
Red Bed & Sand	775
Red Bed, Sand & Salt	1215
Shale - Shells	1500
Shale - Shells & Salt	1745
Lime - Shale	2885
Broken Lime	3015
Lime - Shale	3080
Lime - Shale	3219
Lime	3270
Lime - Shale	3420
Lime - Shale Streaks	3500
Lime and Shale	3575
Sand - Shale	3630
Shale	3660
Brown Lime	3680
Lime - Shale	3710
Lime	4085
Cherty Lime	4096
Lime - Shale	4115
Chert Shale	4135
Lime - Shale	4160
Chert - Lime	4205
Shale - Chert	4249
Shale - Lime	4321
Lime	4326 T.D.

CASING RECORD

8 5/8"	321'
5 1/2"	4322'

FORMATIONS

Heebner	3485
Toronto	3504
Douglas	3526
Lansing	3681
Mississippian	4073
Viola	4150
Simpson	4239
Arbuckle	4321

To the best of my knowledge, the above is a correct and true statement of all formations and where found.

BEN F. BRACK OIL COMPANY, INC.

By *Emil E. Bauer*

Witnessed:

*Udda R. Evans*

February 5, 1951

RECEIVED  
 STATE GEOLOGICAL COMMISSION  
 3-8-51  
 MAR - 8 1951  
 CONSERVATION DIVISION  
 Wichita, Kansas

PLUGGING  
 FILE SEC 21T 20.1W  
 BOX PAGE 65 LINE 7