


Give All Information Completely
Make Required Affidavit
Mail or Deliver Report to:
Conservation Division
State Corporation Commission
212 No. Market
Wichita, Kansas

WELL PLUGGING RECORD

Pratt County. Sec. 23 Twp. 26 Rge. (E) 12 (W)

Location as "NE/CNW/SW" or footage from lines SE SE NE/4
Lease Owner Leben Drilling, Inc.
Lease Name Block Well No. 1
Office Address Box 486, Great Bend, Kansas 67530
Character of Well (completed as Oil, Gas or Dry Hole) oil
Date well completed July 19 19 68
Application for plugging filed June 17 19 69
Application for plugging approved _____ 19 _____
Plugging commenced June 20 19 69
Plugging completed June 26 19 69
Reason for abandonment of well or producing formation depleted

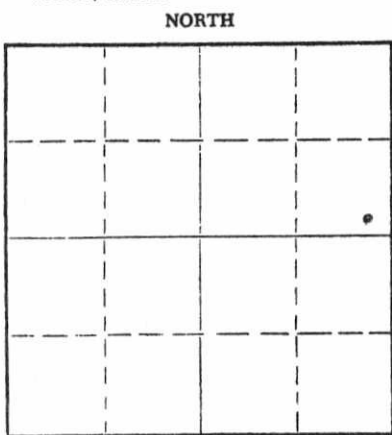

Locate well correctly on above Section Plat

If a producing well is abandoned, date of last production _____ 19 _____
Was permission obtained from the Conservation Division or its agents before plugging was commenced? yes

Name of Conservation Agent who supervised plugging of this well Ralph Warren
Producing formation _____ Depth to top _____ Bottom _____ Total Depth of Well 4405 Feet
Show depth and thickness of all water, oil and gas formations.

OIL, GAS OR WATER RECORDS

CASING RECORD

FORMATION	CONTENT	FROM	TO	SIZE	PUT IN	PULLED OUT
		0	368'	8 5/8"	368'	none
		0	4083'	5 1/2"	4083'	3126.93

Describe in detail the manner in which the well was plugged, indicating where the mud fluid was placed and the method or methods used in introducing it into the hole. If cement or other plugs were used, state the character of same and depth placed, from _____ feet to _____ feet for each plug set.

Sanded back from 4405' to 3920' and dumped 5 sacks of cement.

Squeezed well with 10 sacks gel mud and 75 sacks of cement.

RECEIVED
STATE CORPORATION COMMISSION
JUL 27 1969
CONSERVATION DIVISION
Wichita, Kansas

(If additional description is necessary, use BACK of this sheet)

Name of Plugging Contractor PIPE PULLERS, INC.
Address Box 486, Ellinwood, Kansas

STATE OF Kansas, COUNTY OF Barton, ss. Evelyn Roth (employee of owner) or (~~owner or operator~~) of the above-described well, being first duly sworn on oath, says: That I have knowledge of the facts, statements, and matters herein contained and the log of the above-described well as filed and that the same are true and correct. So help me God.

(Signature) Evelyn Roth
Ellinwood, Kansas
(Address)

SUBSCRIBED AND SWORN to before me this 2nd day of July, 19 69

George A Meyer
Notary Public.

My commission expires Feb. 10, 1971

STENCILED
DEC 21 1968

15-151-20079-0000
Distributed By
KANSAS GEOLOGICAL SOCIETY
508 East Murdock
WICHITA, KANSAS 67214
ROTARY DRILLING LOG

ORIGINAL

Operator:
Beacon Resources Corporation
#1 Block
SE SE NE/4 23-26S-12W
Pratt County, Kansas

Contractor: Omega Drilling, Inc.
Commenced: July 2, 1968
Completed: July 19, 1968

Casing Record:
8 5/8" cemented at 368' w/275 sacks.
5 1/2" cemented at 4083' w/100 sacks.

Prod. Oil

FORMATIONS

205	Surface clay, sand and gravel
366	Red Bed and shale
1750	Shale
2737	Shale and lime
2795	Shale
3675	Shale and lime
4045	Lime
4110	Lime and chert
4162	Lime and shale
4196	Lime
4258	Lime and chert
4318	Lime, sand and chert
4359	Lime, shale and chert
4405	Dolomite
4405	RTD

RECEIVED
STATE CORPORATION COMMISSION
6-18-68
JUN 18 1968
CONSERVATION DIVISION
Wichita, Kansas

We certify that the above log is true and correct to the best of our knowledge and belief.

OMEGA DRILLING, INC.

By *F. S. Woodside, Jr.*
F. S. Woodside, Jr.
President

Subscribed and sworn to before me, a Notary Public, in and for the State of Kansas, County of Sedgwick, this 24th day of July, 1968.

Mary L. Lawrence
Mary L. Lawrence, Notary Public

My commission expires February 28, 1971.