

STATE OF KANSAS
STATE CORPORATION COMMISSION
CONSERVATION DIVISION
P. O. BOX 17027
WICHITA, KANSAS 67217

FORM CP-4

WELL PLUGGING RECORD

Pratt County, Sec. 28 Twp. 26 Rge. 12 (E) W (W)

Location as "NE/CNW/SW" or footage from lines NE NE SW

Lease Owner Wayne L. Kirkman

Lease Name Briggman 'B' Well No. #3

Office Address P. O. Box 143 ; Great Bend, Kansas 67530

Character of Well (completed as Oil, Gas or Dry Hole)

Date well completed 19

Application for plugging filed October 1974

Application for plugging approved October 1974


Plugging commenced November 9 1974

Plugging completed December 20 1974

Reason for abandonment of well or producing formation

If a producing well is abandoned, date of last production 19

Was permission obtained from the Conservation Division or its agents before plugging was commenced? Yes

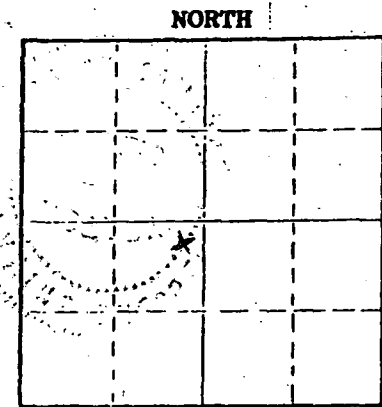

Locate well correctly on above Section Plat

Name of Conservation Agent who supervised plugging of this well Russell Biberstein

Producing formation Depth to top Bottom Total Depth of Well Feet

Show depth and thickness of all water, oil and gas formations.

OIL, GAS OR WATER RECORDS

CASING RECORD

FORMATION	CONTENT	FROM	TO	SIZE	PUT IN	PULLED OUT
				8 5/8"	742'	None
				4 1/2"	4289'	2416

Describe in detail the manner in which the well was plugged, indicating where the mud fluid was placed and the method or methods used in introducing it into the hole. If cement or other plugs were used, state the character of same and depth placed, from feet to feet for each plug set.

November 9, 1974 Plugged off bottom. Dumped sand to 4000'. Mixed and dumped 4 sx of cement.

December 20, 1974 Plugged off top. Sun Oil Well Cementing Co. mixed and pumped down surface casing; 2 sx of hulls, 10 sx of gel and 100 sx of cement.

(If additional description is necessary, use BACK of this sheet)

Name of Plugging Contractor RUSS CASING PULLING, INC.

Address P. O. Box 1082 ; Great Bend, Kansas 67530

STATE OF KANSAS COUNTY OF SEDGWICK

E. F. DAY (employee of owner) or (owner or operator) of the above-described


well, being first duly sworn on oath, says: That I have knowledge of the facts, statements, and matters herein contained and the log of the above-described well as filed and that the same are true and correct. So help me God.

(Signature) E. F. Day

(Address)

Subscribed and sworn to before me this 3rd day of March 1975

My commission expires 2/19/77 Maxine Dressen Notary Public

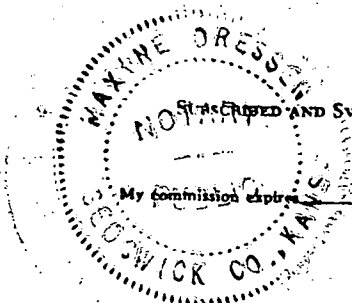

RECEIVED
STATE CORPORATION COMMISSION

MAR 4 1975
3-4-75
CONSERVATION DIVISION
Wichita, Kansas

15-151-10596-0000

COPY


WELL LOG BUREAU—KANSAS GEOLOGICAL SOCIETY
500 East Murdock, Wichita, Kansas

Company- SHELL OIL CO.
Farm- I. Briggeman "B" No. 3

SEC. 28 T. 26 R. 12W
NE NE SW
336' fr NL, 330' fr EL, SW 1/4

Total Depth. 4292 PB 4250
Comm. 5-19-52 Comp. 6-27-52
Shot or Treated.
Contractor.
Issued. 9-6-52

County Pratt
KANSAS

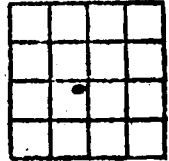

Elevation. 1916

Production. Pot. 2979 BO O BW
24 hrs. by BHPB

CASING:

8 5/8" 742'
4 1/2" 4289'

Figures Indicate Bottom of Formations.

surface	42	shale	3855
sand	290	lime	3867
lime & shale	325	shale	3872
sand	425	lime	3915
red bed	675	shale	3918
red shale & sand	731	lime	3957
anhydrite	755	shale blk	3960
red bed	825	lime	3985
red bed, shale & shells	900	shale varicolored	3997
shale, shells & lime	1170	lime	4010
shale & shells	1280	shale blk & gry	4017
shale & salt	1490	shale brown & red	4025
shale & shells	1690	lime	4067
lime & shale	2145	chert	4099
sand	2175	chert & shale & lime	4105
shale & lime	2405	shale	4113
shale & shells	2525	lime	4169
shale & lime	2600	chert & lime	4182
lime	2607	shale green	4191
shale	2624	lime	4194
lime	2641	shale green	4196
shale	2651	dolomite	4199
lime, shale strks	2673	shale green	4200
shale	2709	dolomite	4201
lime & shale	2723	shale green	4203
shale red, green & brown partly sandy	2754	dolomite	4204
lime & shale	2778	sand	4215
shale	2833	shale	4222
lime	2853	sand	4225
shale	2907	shale & sand	4227
lime	2999	shale	4287
shale	3024	dolomite	4292
lime	3032	Total Depth PB 4250	
shale gry & brown	3060	Tops:	
lime	3117	Topeka	3159
shale	3137	Hoebner Shale	3489
sand	3159	Toronto	3503
lime	3306	Brown Lime	3660
shale	3315	Lansing-Kansas City	3683
lime	3384	Viola Lime	4113
shale	3391	Simpson	4182
lime	3422	Arbuckle	4287
shale blk	3436		
lime	3489	Perforated 4204-26'	
shale blk carbonaceous	3493		
lime, some chert	3497		
shale	3503		
lime	3525		
shale	3660		
lime	3665		
shale	3683		
lime	3731		
shale	3734		
lime	3831		
shale	3836		
lime	3851		

RECEIVED
STATE CORPORATION COMMISSION
DEC 11 1974
12-11-74
CONSERVATION DIVISION
Wichita, Kansas

