

15-151-10597-0000

RECEIVED  
STATE CORPORATION COMMISSION

JAN 20 1975

1-20-75

CONSERVATION DIVISION  
Wichita, Kansas

STATE OF KANSAS  
STATE CORPORATION COMMISSION  
CONSERVATION DIVISION  
P. O. BOX 17027  
WICHITA, KANSAS 67217

WELL PLUGGING RECORD

Pratt County, Sec. 28 Twp. 26 Rge. 12 (E) W (W)

Location as "NE/CNWSW" or footage from lines NE SE SW

Lease Owner Wayne L. Kirkman

Lease Name I. Briggeman Well No. #4

Office Address Box 143 ; Great Bend, Kansas 67530

Character of Well (completed as Oil, Gas or Dry Hole)

Date well completed 19

Application for plugging filed October 19 74

Application for plugging approved October 19 74


Plugging commenced October 25 19 74

Plugging completed December 20 19 74

Reason for abandonment of well or producing formation Arbuckle  
ceased to be commercial

If a producing well is abandoned, date of last production 19

Was permission obtained from the Conservation Division or its agents before plugging was commenced? Yes

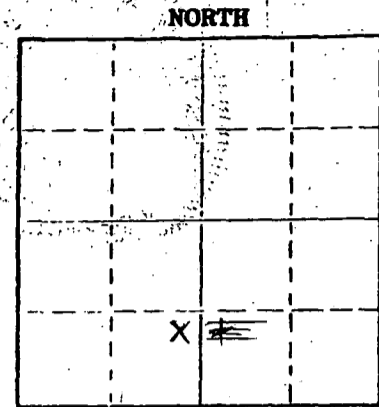

Locate well correctly on above Section Plat

Name of Conservation Agent who supervised plugging of this well Russell Biberstein

Producing formation Depth to top Bottom Total Depth of Well Feet

Show depth and thickness of all water, oil and gas formations.

OIL, GAS OR WATER RECORDS

CASING RECORD

FORMATION	CONTENT	FROM	TO	SIZE	PUT IN	PULLED OUT
				8 5/8"	735	None
				4 1/2"	4281	2441

Describe in detail the manner in which the well was plugged, indicating where the mud fluid was placed and the method or methods used in introducing it into the hole. If cement or other plugs were used, state the character of same and depth placed, from feet to feet for each plug set.

October 25, 1974 Plugged off bottom. Dumped sand to 2600'. Mixed and dumped 4 sx of cement.

December 20, 1974 Plugged off top. Sun Oil Well Cementing Co. mixed and pumped down surface casing; 2 sx of hulls, 10 sx of gel and 100 sx of cement.

(If additional description is necessary, use BACK of this sheet)

Name of Plugging Contractor RUSS CASING PULLING, INC.


Address P. O. Box 1082 ; Great Bend, Kansas 67530

STATE OF KANSAS COUNTY OF SEDGWICK ss.  
E. F. Day (employee of owner) / of (owner or operator) of the above-described

well, being first duly sworn on oath, says: That I have knowledge of the facts, statements, and matters herein contained and the log of the above-described well as filed and that the same are true and correct. So help me God.

(Signature) E. F. Day  
E. F. Day Box 18148, Wichita, Ks 67218  
(Address)

Subscribed and Sworn to before me this 17th day of January, 1975

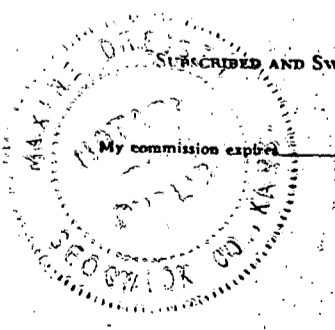

Maxine Dressen  
Notary Public

15-151-10597-0000

COPY


WELL LOG BUREAU—KANSAS GEOLOGICAL SOCIETY  
508 East Myrdock, Wichita, Kansas

Company: SHELL OIL COMPANY  
Farm: I. Briggeman "B" No. 4

SEC. 28 T. 26 R. 12W  
NE SE SW  
1018' SL, 330' SL, SW 1/4

Total Depth. 4287 PB 4243  
Comm. 7-10-52 Comp. 8-7-52  
Shot or Treated.  
Contractor.  
Issued. 9-13-52

County Pratt KANSAS

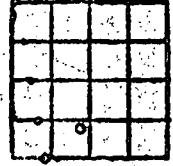

CASING:

8 5/8" 735'  
1 1/2" 4281'

Elevation. 1913

Production. I.P. State Pot. 1365  
bbls & no str by  
BHPB

Figures Indicate Bottom of Formations.

shale, shells 0 - 385  
red bed 600  
sand 726  
anhydrite 750  
shale, shells 1280  
salt, shale 1490  
shale, shells 1570  
shale, shells, lime 2090  
lime, shale 2600  
lime 2608  
shale, strks lime 2625  
lime 2641  
shale, strks lime 2692  
shale, sand 2708  
lime strks shale 2743  
sand 2749  
lime 2758  
shale, sdy shale 2837  
lime, dolomite 2860  
shale, sand 2905  
lime, shale strks 3030  
shale, gry to blk 3058  
lime 3115  
shale & sdy shale 3130  
sand, shale 3155  
lime 3420  
shale blk 3433  
lime 3482  
shale blk 3487  
lime 3491  
shale, lime 3499  
lime, dolomite 3520  
shale sdy 3587  
sand 3600  
shale 3657  
lime 3664  
shale, lime 3677  
lime 3914  
shale 3918  
lime 3953  
shale 3957  
lime 3986  
shale, lime 3992  
lime, shale, trace  
chert 4013  
shale 4017  
lime 4058  
chert, dolomite 4097  
chert, dol, shale 4111  
lime, dolomite,  
chert 4191  
shale green, lime 4201  
sand, dolomite 4211  
sand 4221  
shale 4279  
dolomite 4287

Tops:  
Anhydrite (Scout) 726  
Topeka 3155  
Heebner 3482  
Toronto 3499  
Brown Lime 3657  
Lansing-Kansas City 3677  
Viola 4111  
Simpson 4191  
Arbuckle 4279

4243 P.B. Perforated  
88/4200-22

RECEIVED  
STATE CORPORATION COMMISSION  
SEP 9 1954  
9-9-54  
CONSERVATION DIVISION  
Wichita, Kansas

Total Depth  
P. B. 4243