

15-151-10599-0000

STATE OF KANSAS  
STATE CORPORATION COMMISSION


Give All Information Completely  
Make Required Affidavit  
Mail or Deliver Report to:  
Conservation Division  
State Corporation Commission  
211 No. Broadway  
Wichita, Kansas

WELL PLUGGING RECORD  
(CORRECTED REPORT)

Pratt County. Sec. 28 Twp. 26S Rge. (E) 12 (W)

Location as "NE/CNWxSWx" or footage from lines SW SW NW  
Lease Owner Shell Oil Company  
Lease Name O. H. HOEME Well No. 1  
Office Address P. O. Box 426, Wichita 1, Kansas  
Character of Well (completed as Oil, Gas or Dry Hole) Oil  
Date well completed September 9 19 53  
Application for plugging filed September 4 19 56  
Application for plugging approved September 5 19 56  
Plugging commenced August 31 19 56  
Plugging completed September 4 19 56  
Reason for abandonment of well or producing formation Oil Depleted

NORTH

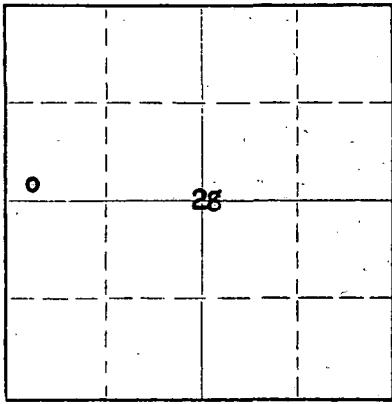

Locate well correctly on above  
Section Plat

If a producing well is abandoned, date of last production August 9 19 56  
Was permission obtained from the Conservation Division or its agents before plugging was commenced? Yes

Name of Conservation Agent who supervised plugging of this well M. A. Rives  
Producing formation Arbuckle Depth to top Bottom Total Depth of Well 4304 Feet  
Show depth and thickness of all water, oil and gas formations. FB 3940

OIL, GAS OR WATER RECORDS

CASING RECORD

FORMATION	CONTENT	FROM	TO	SIZE	PUT IN	PULLED OUT
Arbuckle	IP 3000 BO & 0 wtr 24 hrs.	4271	4304	8-5/8" 1 1/2"	812' 4271'	None 1546'
Lansing-Kansas City	IP 10 BO & 30 BW 24 hrs.	3913	3927			

Describe in detail the manner in which the well was plugged, indicating where the mud fluid was placed and the method or methods used in introducing it into the hole. If cement or other plugs were used, state the character of same and depth placed, from feet to feet for each plug set.

PB 4304-4290 with 15 gal. Ottawa sand.  
PB 4290-4279 with 10 gal. plastic.  
PB 4279-4269 with 3 gal. Ottawa sand & 27 1/2 gal. plastic.  
Set CIBP at 3970.  
PB 3970-3959 with 1 sack cement.  
PB 3959-3940 with 1 sack cement.

Measured in to PBFD 3940. Filled hole with sand to 3900.  
Dumped 5 sax cement with bailer to 3840. Filled hole  
with heavy mud to 300'. Set permanent rock bridge to  
290'. Dumped 20 sax cement to 227'. Filled hole with  
heavy mud to 45', set rock bridge to 35' and dumped 10  
sax cement for cap on well.

(If additional description is necessary, use BACK of this sheet)

Name of Plugging Contractor Forbes Casing Pulling Company  
Address P. O. Box 221, Great Bend, Kansas

STATE OF KANSAS COUNTY OF SEDGWICK ss.

J. W. Sutton (employee of owner) of the above-described well, being first duly sworn on oath, says: That I have knowledge of the facts, statements, and matters herein contained and the log of the above-described well as filed and that the same are true and correct. So help me God.

(Signature)

P. O. Box 426, Wichita 1, Kansas  
(Address)

SUBSCRIBED AND SWORN to before me this 30th day of October, 19 56

My commission expires April 16, 1960

Betty Peaslee  
RECEIVED  
Notary Public.  
STATE CORPORATION COMMISSION

LB

PLUGGING  
FILE SEC. 28 T. 26 R. 12W  
BOOK PAGE 95 LINE 42

OCT 31 1956  
10-31-56  
CONSERVATION DIVISION  
Wichita, Kansas

SHELL-O. H. HOEME #1  
 SW SW NW Section 28-26S-12W  
 Iuka-Carmi Field  
 Pratt County, Kansas

Casing Record

8-5/8" cem 812 with 400 sax; cem. circ.  
 4 1/2" cem 4271 with 750 sax; top cement @  
 1550'; perforated 4260-71 & 3913-27.

0 - 153 soil, clay & sand  
 245 sand  
 590 red rock & shale  
 1260 shale & shells  
 1675 shale & salt  
 1815 shale, lime & anhydrite  
 2458 lime & shale  
 2550 shale  
 2632 shale & lime  
 2722 shale & shells  
 3207 shale & lime  
 4052 lime  
 4072 chert & lime  
 4073 chert  
 4107 chert & lime  
 4158 lime & chert  
 4255 lime  
 4304 dolomite T.D.  
 3940 P.B.

Formation Tops

Lansing-Kansas City 3675  
 Viola 4100  
 Simpson 4154  
 Arbuckle 4259

Plug-Back Information

PB to 4290 with 15 gallons Ottawa sand.  
 PB to 4279 with 10 gallons plastic.  
 PB to 4269 with 3 gallons Ottawa sand & 27 1/2 gallons plastic.  
 Set CIBP at 3970.  
 PB to 3940 with 2 sacks cement.

RECORDED  
 STATE DEPT.

9-5-56  
 CONS. DIV.  
 WICHITA, KANSAS  
 PLUGGING  
 FILE SEC 28 T 26 R 12W  
 BOOK PAGE 95 LINE 42