

15-151-10932-00-01


STATE OF KANSAS  
STATE CORPORATION COMMISSION

WELL PLUGGING RECORD

Give All Information Completely  
Make Required Affidavit  
Mail or Deliver Report to:  
Conservation Division  
State Corporation Commission  
211 No. Broadway  
Wichita, Kansas

Pratt County. Sec. 28 Twp. 26S Rge. (#) 12 (W)  
Location as "NE/CNW%SW%" or footage from lines SW NW NW  
Lease Owner Shell Oil Company  
Lease Name O. H. HOEME Well No. 3  
Office Address Box 744, Great Bend, Kansas  
Character of Well (completed as Oil, Gas or Dry Hole) Oil  
Date well completed September 19 19 44  
Application for plugging filed August 27 19 58  
Application for plugging approved - 19  
Plugging commenced September 5 19 58  
Plugging completed September 9 19 58  
Reason for abandonment of well or producing formation Oil Depleted

NORTH

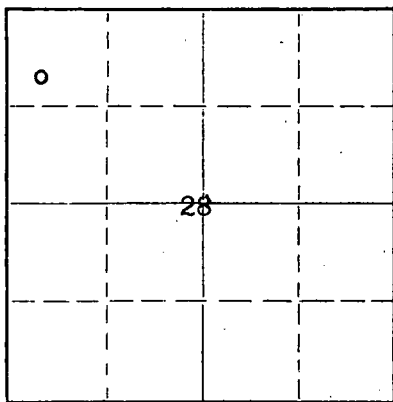

Locate well correctly on above  
Section Plat

If a producing well is abandoned, date of last production July 23 19 58  
Was permission obtained from the Conservation Division or its agents before plugging was commenced? Yes

Name of Conservation Agent who supervised plugging of this well W. L. Lackamp  
Producing formation Arbuckle Depth to top 4275 Bottom \_\_\_\_\_ Total Depth of Well 4312 Feet  
Show depth and thickness of all water, oil and gas formations. PB 3937

OIL, GAS OR WATER RECORDS

CASING RECORD

FORMATION	CONTENT	FROM	TO	SIZE	PUT IN	PULLED OUT
Arbuckle	I.P. 81 BO &	4278	4312	8 5/8"	806'	None
	198 BW 24 hrs				4278'	1521'
	9-19-44					
Lansing-Kansas City	I.P. 1 BO & 20	3878	3883			
	BW 24 hours					
	1-6-58					

Describe in detail the manner in which the well was plugged, indicating where the mud fluid was placed and the method or methods used in introducing it into the hole. If cement or other plugs were used, state the character of same and depth placed, from \_\_\_\_\_ feet to \_\_\_\_\_ feet for each plug set.

Filled hole with sand to 3865. Dumped 5 sax cement to 3805. Filled hole with mud to 310. Set rock bridge to 300 & dumped 20 sax cement to 236. Filled hole with mud to 40, set rock bridge to 30 & dumped 10 sax cement to base of cellar.

RECEIVED  
STATE CORPORATION COMMISSION  
9-16-58  
SEP 16 1958

(If additional description is necessary, use BACK of this sheet)  
Name of Plugging Contractor J. O. Forbes d/b/a Forbes Casing Pulling Co.  
Address Box 221, Great Bend, Kansas

STATE OF KANSAS, COUNTY OF BARTON, ss.  
A. W. Weber (employee of owner) ~~owner~~ of the above-described well, being first duly sworn on oath, says: That I have knowledge of the facts, statements, and matters herein contained and the log of the above-described well as filed and that the same are true and correct. So help me God.

(Signature) A. W. Weber  
Box 744, Great Bend, Kansas  
(Address)

SUBSCRIBED AND SWORN TO before me this 12th day of September, 19 58  
L. Mont Byers, Jr.  
Notary Public.

My commission expires January 28, 1961

LB

PLUGGING  
FILE SEC. 28 T. 26 R. 12W  
BOOK PAGE 126 LINE 9

SHELL-O. H. HOEME #3  
 SW NW NW 28-26S-12W  
 Iuka-Carmi Field  
 Pratt County, Kansas

Casing Record

8 5/8" cem 806 with 400 sax  
 4 1/2" cem 4278 with 800 sax; perforated 3878-3883

0 - 780 soil, clay, sand, shale &  
 shells & red bed

812 red bed  
 1290 shale & shells  
 1600 shale & salt  
 1680 salt & shale  
 2200 lime & shale  
 2235 shale & lime  
 2285 lime  
 2335 lime & shale  
 2520 shale & lime  
 2610 shale  
 2775 shale & lime  
 3180 lime & shale  
 3230 lime  
 3493 lime & shale  
 3511 lime  
 3648 lime & shale  
 4005 lime  
 4036 lime & chert  
 4076 lime  
 4090 lime & chert  
 4095 chert  
 4098 chert (& junk)  
 4146 lime & chert  
 4159 chert & shale  
 4165 lime  
 4183 lime & sandy lime  
 4193 shale  
 4206 dolomite & sand  
 4215 dolomite  
 4229 shale  
 4246 lime & shale  
 4252 sand  
 4258 lime  
 4270 shale  
 4312 dolomite T.D. PBTB 3937.

## Plug Back Data:

4312-4310 with leadwool.  
 4310-4307 with wood limit plug.  
 4307-4288 with sand & plastic.  
 Set CIBP at 3950.  
 Capped with 1 sack cement to 3937.

## Formation Tops:

Topeka 3153  
 Lansing-Kansas City 3698  
 Viola 4115  
 Simpson 4183  
 Arbuckle 4275

RECEIVED  
 STATE CORPORATION COMMISSION

AUG 28 1958  
 8-28-58  
 CONSERVATION DIVISION  
 Wichita, Kansas

## PLUGGING

FILE SEC 28 T 26 R 12W  
 BOOK PAGE 126 LINE 9