

STATE OF KANSAS  
 STATE CORPORATION COMMISSION  
 200 Colorado Derby Bldg.  
 Wichita, Kansas 67202


Form CP-4  
 Rev. 12-15-80

WELL PLUGGING RECORD

15-15-20902-00-00

Give All Information Completely  
 Make Required Affidavit

COUNTY Marion SEC. 20 TWP. 21S RGE. 5E E/W  
 Location as in quarters or footage from lines:  
1,980' North Line 660' West Line C SW NW

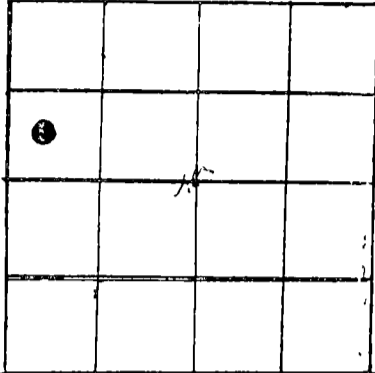

Locate Well  
 correctly on above  
 Section Platt.

Lease Owner Atlantis Oil Corporation  
 Lease Name Freeborn A Well No. A-2  
 Office Address P.O. Box 12108, Wichita, KS 67277  
 Character of Well (Completed as Oil, Gas or Dry Hole): Dry Hole  
 Date Well Completed 6/4/82  
 Application for plugging filed 8-23-82  
 Plugging commenced 9-1-82  
 Plugging completed 9-13-82  
 Reason for abandonment of well or producing formation Dry

Was permission obtained from the Conservation Division or it's  
 Agent's before plugging was commenced? yes 6-23-82

Name of Conservation Agent who supervised plugging of this well Mr Unruh  
 Producing formation Hunton Depth to top 2340 bottom 2,348 T.D. 2,348'  
 Show depth and thickness of all water, oil and gas formations.

OIL, GAS OR WATER RECORDS

Casing Record

| Formation | Content  | From | To   | Size        | Put in | Pulled Out |
|-----------|----------|------|------|-------------|--------|------------|
| Hunton    | Dolomite | 2340 | 2348 | 5 1/2 14lbs | 2,347' | 981'       |
|           |          |      |      |             |        |            |
|           |          |      |      |             |        |            |
|           |          |      |      |             |        |            |

Describe in detail the manner in which the well was plugged, indicating where the mud  
 fluid was placed and the method or methods used in introducing it into the hold. If cement  
 or other plugs were used, state the character of same and depth placed, from 2,335  
 feet to 2275 feet for each plug set. 75' sand plug was set on bottom of squeezed  
 off open hole. 6 sacks of cement run on dump bailer to sand plug to P.B.T.D.  
 of 2,275'. Shot off casing at 1,366' and pulled out of hole. Bailer run  
 and mud vis checked ast 32 vis. Set rock bridge at 375' and filled hole  
 with 3 yards cement. Cut off squeezed pipe below plow depth.


(If additional description is necessary, use BACK of this sheet)

Name of Plugging Contractor Atlantis Oil Corporation

STATE OF Kansas COUNTY OF Sedgwick, ss.  
J. E. Newman (employee of owner) or (owner or operator) of the  
 above-described well, being first duly sworn on oath, says: That I have knowledge of the  
 facts, statements, and matters herein contained and the log of the above-described well as  
 filed and that the same are true and correct. So help me God J. E. Newman

(Signature) [Signature]  
 P.O. Box 12108 Wichita, KS 67277  
 (Address) 67277

SUBSCRIBED AND SWORN TO before me this 28th day of December, 19 82

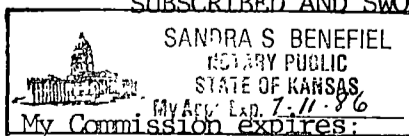

July 11, 1986

Sandra S. Benefiel  
 Notary Public.

