


WELL PLUGGING RECORD

Give All Information Completely
Make Required Affidavit
Mail or Deliver Report to:
Conservation Division
State Corporation Commission
800 Bittling Building
Wichita, Kansas

..... Barton County. Sec. 5 Twp. 20 Rge. XE 12 (W)
Location as "NE/CNW $\frac{1}{4}$ SW $\frac{1}{4}$ " or footage from lines NE NE SW
Lease Owner Derby Oil Company
Lease Name Steckel Well No. 1
Office Address Wichita, Kansas
Character of Well (completed as Oil, Gas or Dry Hole) Dry Hole
Date well completed August 27, 19 51
Application for plugging filed September 18, 19 51
Application for plugging approved September 24, 19 51
Plugging commenced September 18, 19 51
Plugging completed September 22, 19 51
Reason for abandonment of well or producing formation Dry Hole
If a producing well is abandoned, date of last production 19.....
Was permission obtained from the Conservation Division or its agents before plugging was commenced? Yes

NORTH

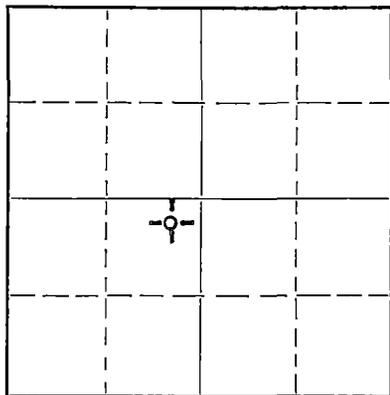

Locate well correctly on above Section Plat

Name of Conservation Agent who supervised plugging of this well Stough
Producing formation Depth to top Bottom Total Depth of Well 3415 Feet
Show depth and thickness of all water, oil and gas formations.

OIL, GAS OR WATER RECORDS

CASING RECORD

| Formation | Content | From | To | Size | Put In | Pulled Out |
|-----------|---------|------|----|--------|--------|------------|
| | | | | 5 1/2" | | 2722' |
| | | | | 8 5/8" | 165 | None |
| | | | | | | |
| | | | | | | |
| | | | | | | |
| | | | | | | |
| | | | | | | |
| | | | | | | |
| | | | | | | |

Describe in detail the manner in which the well was plugged, indicating where the mud fluid was placed and the method or methods used in introducing it into the hole. If cement or other plugs were used, state the character of same and depth placed, from feet to feet for each plug set.

Rocked hole from 3250' to 3150' and ran 5 sacks of cement. Pumped in 100 barrels of pit mud and followed with 100 sacks of cement. Mudded hole to 9' and ran 3 sacks of cement. Plugging completed.

007-4-1951 10-04-51

(If additional description is necessary, use BACK of this sheet)

Correspondence regarding this well should be addressed to West Supply Company
Address Chase, Kansas

STATE OF Kansas, COUNTY OF Sedgwick, ss.
F. W. Heiser (employee of owner) or (owner or operator) of the above-described well, being first duly sworn on oath, says: That I have knowledge of the facts, statements, and matters herein contained and the log of the above-described well as filed and that the same are true and correct. So help me God.

(Signature) F. W. Heiser
F. W. Heiser, Exploitation Engineer
Box 1030, Wichita, Kansas
(Address)

SUBSCRIBED AND SWORN to before me this 2nd day of October, 19 51

H. A. Bilson
H. A. Bilson, Notary Public.

My commission expires August 24, 1953

PLUGGING
FILE SEC 5: 70 R/W
BOOK PAGE 111 LINE 18

DRILLER'S LOG

COMPANY: HILTON DRILLING COMPANY, INC. ET AL LOCATION: NE NE SW 5-20-12
 Barton County, Kansas
 CONTRACTOR: HILTON DRILLING COMPANY, INC.
 FARM NAME: STECKEL NO. 1 ELEVATION: 1825 DF
 COMMENCED: 7-26-51
 COMPLETED: 8-9-51
 CASINO USED: 8-5/8" at 165' with 175 sacks
 5-1/2" at 3401' with 100 sacks

| | |
|---------------------------|------|
| Sand, Gravel | 85 |
| Hard Sand | 110 |
| Hard Sand | 140 |
| Gray Shale and Shells | 164 |
| Hard Sand and Shale | 200 |
| Red Bed | 540 |
| Sand | 565 |
| Red Bed and Shale | 640 |
| Anhydrite | 665 |
| Shale | 690 |
| Shale and Shells | 1075 |
| Salt, Shale and Shells | 1465 |
| Broken Lime and Shale | 1640 |
| Lime | 1900 |
| Broken Lime and Shale | 1990 |
| Broken Lime, Iron Streaks | 2150 |
| Lime and Shale | 2280 |
| Shale, Lime, Shells | 2430 |
| Lime and Shale | 2660 |
| Shale, Broken Lime | 2740 |
| Lime and Shale | 2825 |
| Lime | 3057 |
| Lime and Shale | 3150 |
| Lime | 3401 |
| Arbuckle | 3410 |
| Total Depth | 3410 |

STATE OF KANSAS)
) SS
 COUNTY OF BARTON)

OCT 4 1951

I, the undersigned, being duly sworn on oath, state that the above statement and log are true and a correct record and log of the well drilled at the location above described.

HILTON DRILLING COMPANY, INC.

C. N. Hilton
 President

Subscribed and sworn to before me this 11th day of August, 1951.

Edwina Elder
 Notary Public

My commission expires September 21, 1953.

PLUGGING
 FILE SEC 5 T 20 R 12
 BOOK PAGE 141