


STATE OF KANSAS
STATE CORPORATION COMMISSION

15-009-30435-0000
Form CP-4

WELL PLUGGING RECORD

Give All Information Completely
Make Required Affidavit
Mail or Deliver Report to
Conservation Division
State Corporation Commission
212 No. Market
Wichita, Kansas

NORTH

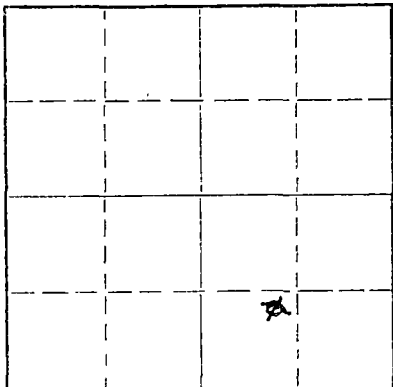

Locate well correctly on above
Section Plat

Barton County, Sec. 12 Twp. 20S Rge. (E) 13 (W)
Location as "NE/CNW/SW" or footage from lines NE SW SE

Lease Owner LEO J. DREILING OIL CO.

Lease Name Parrish B Well No. 1

Office Address Victoris, Kansas

Character of Well (completed as Oil, Gas or Dry Hole) Dry Hole

Date well completed 7-30 19 66

Application for plugging filed 7-30 19 66

Application for plugging approved 7-30 19 66

Plugging commenced 3:00 P.M. 7-30 19 66

Plugging completed 9:00 P.M. 7-30 19 66

Reason for abandonment of well or producing formation Dry Hole

If a producing well is abandoned, date of last production none 19 66

Was permission obtained from the Conservation Division or its agents before plugging was commenced? yes

Name of Conservation Agent who supervised plugging of this well Don Truan, Russell, Kanas

Producing formation none Depth to top _____ Bottom _____ Total Depth of Well 3477 Feet

Show depth and thickness of all water, oil and gas formations.

OIL, GAS OR WATER RECORDS

CASING RECORD

FORMATION	CONTENT	FROM	TO	SIZE	PUT IN	PULLED OUT

Describe in detail the manner in which the well was plugged, indicating where the mud fluid was placed and the method or methods used in introducing it into the hole. If cement or other plugs were used, state the character of same and depth placed, from _____ feet to _____ feet for each plug set.

Set Plug and Hulls @ 230', Cemented with 25 sacks through drill pipe.

Mud and Plug with hulls @ 40' with 10 sacks cement. Plugged rat hole with 2 sacks cement.

RECEIVED
STATE CORPORATION COMMISSION

AUG 2 1966

08-02-66

CONSERVATION DIVISION
Wichita, Kansas

(If additional description is necessary, use BACK of this sheet)

Name of Plugging Contractor B & B Drilling Inc.

Address 548 Petroleum Building

STATE OF Kansas, COUNTY OF Sedgwick, ss.

Bill Lahar (~~employee~~ of owner) or (owner or operator) of the above-described

well, being first duly sworn on oath, says: That I have knowledge of the facts, statements, and matters herein contained and the log of the above-described well as filed and that the same are true and correct. So help me God.

(Signature) Bill Lahar

1311 Seville, Wichita, Kansas
(Address)

SUBSCRIBED AND SWORN TO before me this 1st day of August, 19 66

Alma G. Meiser

My commission expires May 31, 1970

Notary Public.

B & B DRILLING, INC.

548 Petroleum Building
Wichita, Kansas 67202
August 1, 1966

RECEIVED
STATE CORPORATION COMMISSION

AUG 2 1966

CONSERVATION DIVISION
Wichita, Kansas

DRILLERS LOG

Re: Parrish B- 1
NE SW SE
Sec.12-20S-13W
Barton County, Kansas

COMPANY: Leo J. Dreiling & Sons, Inc.
CONTRACTOR: B & B Drilling Inc.
TOTAL DEPTH: 3477'
COMMENCED: 7-23-66
COMPLETED 7-30-66

0	106 Sand
106	240 Clay and shale (surface hole)
240	670 Shale and red beds
670	692 Anhydrite
692	1690 Shale and Shells
1690	2215 Lime and Shale
2215	3071 Lime and Shale
	3071(Top Heebner)
3071	3203 Lime and Shale
	3203 (Top Lansing)
3203	3428 Lime (Base Kansas City)
3428	3443 Shale and Lime
	3443 (Conglomerate) top
3443	3457 Conglomerate
	3457 (Top Arbuckle)
3457	3477 Lime
	3477 Total Depth D & A

We certify the above and foregoing to be true and correct copy of the log on the Parrish B-1, located in Barton County, Kansas

B & B DRILLING INC.

Bill Lalor President

Alma A. Neuser
Notary Public