


WELL PLUGGING RECORD

Give All Information Completely  
Make Required Affidavit  
Mail or Deliver Report to:  
Conservation Division  
State Corporation Commission  
800 Bitting Building  
Wichita, Kansas

Barton County, Sec. 12 Twp. 20 Rge. 13 (E) W (W)  
Location as "NE/CNW $\frac{1}{4}$ SW $\frac{1}{4}$ " or footage from lines SE SE SE  
Lease Owner Hilton Drilling Company, Inc.  
Lease Name Parish Well No. 1  
Office Address 2421 Tenth Street, Great Bend, Kansas  
Character of Well (completed as Oil, Gas or Dry Hole) Dry Hole  
Date well completed August 19 19 52  
Application for plugging filed " 19 19 52  
Application for plugging approved " 19 19 52  
Plugging commenced " 19 19 52  
Plugging completed " 19 19 52  
Reason for abandonment of well or producing formation dry hole

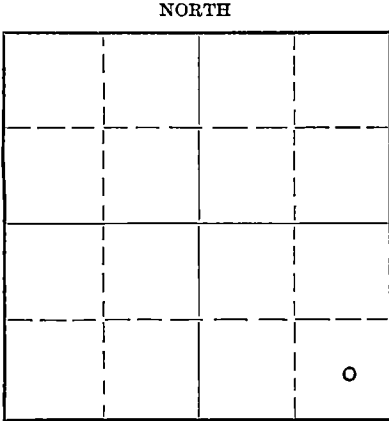

Locate well correctly on above Section Plat

If a producing well is abandoned, date of last production 19  
Was permission obtained from the Conservation Division or its agents before plugging was commenced? yes

Name of Conservation Agent who supervised plugging of this well C. D. Stough  
Producing formation \_\_\_\_\_ Depth to top \_\_\_\_\_ Bottom \_\_\_\_\_ Total Depth of Well 3113 Feet  
Show depth and thickness of all water, oil and gas formations.

OIL, GAS OR WATER RECORDS

CASING RECORD

Formation	Content	From	To	Size	Put In	Pulled Out
				8 5/8	197'	none

Describe in detail the manner in which the well was plugged, indicating where the mud fluid was placed and the method or methods used in introducing it into the hole. If cement or other plugs were used, state the character of same and depth placed, from \_\_\_\_\_ feet to \_\_\_\_\_ feet for each plug set.

Hole was filled with heavy rotary mud from bottom to 180'. Plug down at 180' and cemented with 20 sks. cement through pipe then hole filled with heavy rotary mud to 35'. Plug set at 35' and cemented with 10 sks. cement to surface.

RECEIVED  
CONSERVATION DIVISION  
AUG 26 1952  
WICHITA, KANSAS

(If additional description is necessary, use BACK of this sheet)  
Name of Plugging Contractor Hilton Drilling Company, Inc.  
Address P.O. Box 164, Great Bend, Kansas

STATE OF KANSAS, COUNTY OF BARTON, ss.  
Henry Peacock, Secretary (employee of owner) or (owner or operator) of the above-described well,

being first duly sworn on oath, says: That I have knowledge of the facts, statements, and matters herein contained and the log of the above-described well as filed and that the same are true and correct. So help me God.

(Signature) Henry Peacock Secretary  
2421 Tenth Street, Great Bend, Kansas  
(Address)

SUBSCRIBED AND SWORN TO before me this 25th day of August, 19 52

Margaret Whitman  
Notary Public.

My commission expires 4-4-56

PLUGGING  
FILE SEC 12 TWP 20 R 13  
BOOK PAGE 39 OF 22

