


15-185-21-1626 00-00

WELL PLUGGING RECORD

Give All Information Completely
 Make Required Affidavit

COUNTY Stafford SEC. 15 TWP. 24S RGE 15 W R/W
 Location as in quarters or footage from lines:
C E/2

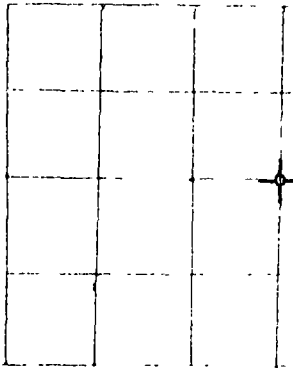

Locate Well
 correctly on above
 Section Plat.

Lease Owner F. G. Holl
 Lease Name Cummins #5-15 Well No. 5-15
 Office Address 6427 East Kellogg, Wichita, Kansas 67207
 Character of Well (Completed as Oil, Gas or Dry Hole): Dry Hole
 Date Well Completed July 1, 1982
 Application for plugging filed June 30, 1982
 Plugging commenced 4:30 AM, July 1, 1982
 Plugging completed 6:00 AM, July 1, 1982
 Reason for abandonment of well or producing formation Dry Hole

Was permission obtained from the Conservation Division or it's
 Agent's before plugging was commenced? Yes

Name of Conservation Agent who supervised plugging of this well J. H. Metz

Producing formation _____ Depth to top _____ bottom T.D. 4265'

Show depth and thickness of all water, oil and gas formations.

OIL, GAS OR WATER RECORDS

Casing Record

Formation	Content	From	To	Size	Put in	Pulled Out
				8 5/8"	265'	None

Describe in detail the manner in which the well was plugged, indicating where the mud fluid was placed and the method or methods used in introducing it into the hold. If cement or other plugs were used, state the character of same and depth placed, from _____ feet to _____ feet for each plug set.

Filled hole with heavy mud.
 Heavy mud to 770' with 60 sacks through open ended
 drill pipe; heavy mud to 240' with 40 sacks through
 open ended drill pipe; heavy mud to 40' with 1/2 sack hulls and
 Howco plug with solid bridge at 40'; 10 sacks to surface;
 10 sacks in rathole and 10 sacks in waterwell.
 Used 50/50 Pozmix with 2% gel and 3% cc.

(If additional description is necessary, use BACK of this sheet)

Name of Plugging Contractor Sterling Drilling Company, P. O. Box 129, Sterling, Ks. 67579

STATE OF KANSAS COUNTY OF RICE, ss.

Bernard Laudermilk (employee of owner) or (owner or operator) of the above-described well, being first duly sworn on oath, says: That I have knowledge of the facts, statements, and matters herein contained and the log of the above-described well as filed and that the same are true and correct. So help me God.

STERLING DRILLING COMPANY

(Signature)

Bernard Laudermilk, President
P. O. Box 129, Sterling, Ks. 67579
 (Address)

SUBSCRIBED AND SWORN TO before me this 2nd day of July, 19 82.

Agnes D. Wurst, Notary Public.

My Commission expires _____

RECEIVED
 STATE CORPORATION COMMISSION
 OCT 28 1983
 CONSERVATION DIVISION
 Wichita, Kansas