


1503920(4) 0000

WELL PLUGGING RECORD

Give All Information Completely  
 Make Required Affidavit

COUNTY Decatur SEC. 26 TWP. 2 RGE. 30 E/W  
 Location as in quarters or footage from lines:  
C/NW/SW

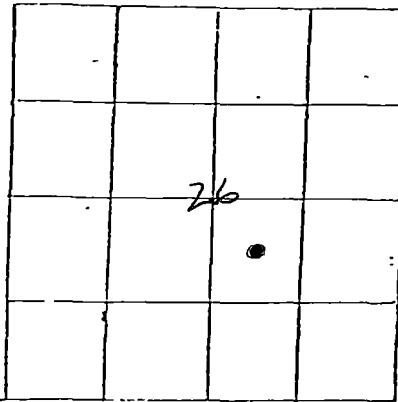

Locate Well  
 correctly on above  
 Section Platt.

Lease Owner Kimbark Oil & Gas Company  
 Lease Name Millage Well No. #1  
 Office Address Box 1516 - Dodge City, Ks. 67801  
 Character of Well (Completed as Oil, Gas or Dry Hole): Oil  
 Date Well Completed \_\_\_\_\_  
 Application for plugging filed January 24, 1983  
 Plugging commenced June 21, 1983  
 Plugging completed June 28, 1983  
 Reason for abandonment of well or producing formation  
Depleted  
 Was permission obtained from the Conservation Division or it's  
 Agent's before plugging was commenced? Yes

Name of Conservation Agent who supervised plugging of this well Carl Goodrow  
 Producing formation \_\_\_\_\_ Depth to top \_\_\_\_\_ bottom \_\_\_\_\_ T.D. 4060'  
 Show depth and thickness of all water, oil and gas formations.

OIL, GAS OR WATER RECORDS

Casing Record

Formation	Content	From	To	Size	Put in	Pulled Out
				8 5/8"	250'	NONE
				5 1/2"	4017'	2010.77'

Describe in detail the manner in which the well was plugged, indicating where the mud fluid was placed and the method or methods used in introducing it into the hold. If cement or other plugs were used, state the character of same and depth placed, from \_\_\_\_\_ feet to \_\_\_\_\_ feet for each plug set.

Dumped five (5) sacks cement, sanded to 3800' and dumped five (5) sacks cement. Shot casing at 3000', 2500', 2200' and 2000'.  
 Pulled forty-nine (49) joints 5 1/2" casing.  
 Squeezed well with two (2) sacks hulls, thirteen (13) sacks gel, one hundred (100) sacks cement, twenty-seven (27) sacks gel, released plug and pumped seventy (70) sacks 50/50 pozmix cement with 6% added gel and 3% calcium chloride.

RECEIVED  
 STATE CORPORATION COMMISSION


(If additional description is necessary, use BACK of this sheet)  
 Name of Plugging Contractor Rockhold Engineering, Inc. OCT 14 1983

CONSERVATION DIVISION  
 Wichita, Kansas

STATE OF KANSAS COUNTY OF BARTON, ss.  
James W. Rockhold (employee of owner) or (owner or operator) of the above-described well, being first duly sworn on oath, says: That I have knowledge of the facts, statements, and matters herein contained and the log of the above-described well as filed and that the same are true and correct. So help me God.

(Signature) James W. Rockhold  
 JAMES W. ROCKHOLD - Box 698 - Great Bend, Ks.  
 (Address) 67530

SUBSCRIBED AND SWORN TO before me this 14th day of July, 1983

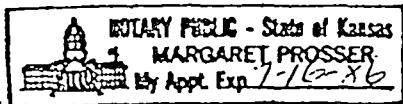

Margaret Prosser  
 Notary Public.

My Commission expires: \_\_\_\_\_

JUL 18 1983

COPY