

STATE OF KANSAS
STATE CORPORATION COMMISSION

WELL PLUGGING RECORD

Give All Information Completely
Make Required Affidavit
Mail or Deliver Report to
Conservation Division
State Corporation Comm.
245 North Water
Wichita, KS 67202

Barber County, Sec. 5 Twp. 34S Rge. 13W E/W
Location as "NE/CNW $\frac{1}{4}$ SW $\frac{1}{4}$ " or footage from lines
NE SE NW

Lease Owner Molz Oil Company
Lease Name Blunk Well No. 4
Office Address R.R. #2 - Kiowa, Kansas 67070


Character of Well (Completed as Oil, Gas or Dry Hole)
Dry Hole

Date Well completed 7-8 1982
Application for plugging filed 7-8 1982
Application for plugging approved 7-8 1982
Plugging commenced 7-8 1982
Plugging completed 7-8 1982
Reason for abandonment of well or producing formation

Dry
If a producing well is abandoned, date of last production 19

Was permission obtained from the Conservation Division or its agents before plugging was commenced? Yes

Name of Conservation Agent who supervised plugging of this well Maurice Leslie
Producing formation Depth to top Bottom Total Depth of Well
Show depth and thickness of all water, oil and gas formations.

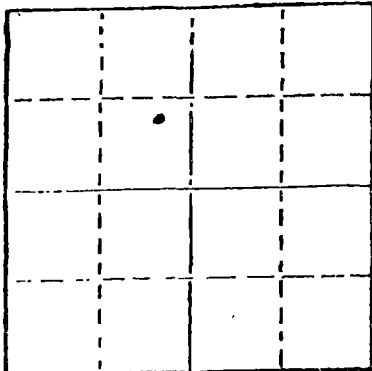

Locate well correctly on above Section Plot

OIL, GAS OR WATER RECORDS

CASING RECORD

FORMATION	CONTENT	FROM	TO	SIZE	PUT IN	PULLED OUT

Describe in detail the manner in which the well was plugged, indicating where the mud fluid was placed and the method or methods used in introducing it into the hold. If cement or other plugs were used, state the character of same and depth placed, from feet to feet for each plug set.

- Filled hole with heavy mud.
- #1 Plug set @ 1250' with 60 sacks cement
- #2 Plug set @ 220' with 50 sacks cement
- #3 Plug set @ 40' with 25 sacks cement
- #4 Plug set in rat hole with 10 sacks cement

(If additional description is necessary, use BACK of this sheet)

Name of Plugging Contractor Sweetman Drilling Inc.

STATE OF Kansas COUNTY OF Barton, ss.
Gary L. Hawk (employee of owner) or (owner or operator)

of the above-described well, being first duly sworn on oath, says: That I have knowledge of the facts, statements, and matters herein contained and the log of the above-described well as filed and that the same are true and correct. So help me God.

(Signature) Gary L. Hawk
Box 645, Great Bend, Kansas 67530
(Address)

SUBSCRIBED AND SWORN TO before me this 28th day of July, 19 82

Walter A. Becker
Barton County Notary Public.

My commission expires September 4, 1985



WELL LOG
Blunk #4
NE SE NW 5-34S-13W
Barber County, Kansas

Name of Operator: Molz Oil Co.
R.R #2
Kiowa, Kansas 67070


Date Completed: July 8, 1982

<u>FROM</u>	<u>TO</u>	
4980	5025	Miss
5025	5045	K.H.
5045		Total Depth

STATE OF KANSAS

COUNTY OF BARTON ss

Gary L. Hawk, Secretary of Sweetman Drilling, Inc. being first duly sworn on oath says: That I have knowledge of the facts, statements and matters herein contained and the log of the above described well as filed and that the same are true and correct.

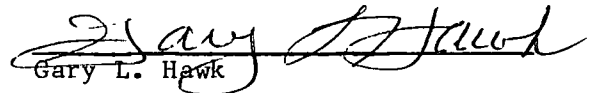
Gary L. Hawk

Subscribed and sworn before me this 28th day of July, 1982.


Notary Public Barton County

My commission expires 9-4-85



RECEIVED
STATE CORPORATION COMMISSION
OCT 21 1983
CONSERVATION DIVISION
Wichita, Kansas