

15 173 20398 0000

STATE OF KANSAS
STATE CORPORATION COMMISSION
200 Colorado Derby Bldg.
Wichita, Kansas 67202

Form CP-4
Rev. 12-15-80

WELL PLUGGING RECORD

Give All Information Completely
Make Required Affidavit

COUNTY Sedgwick SEC. 5 TWP. 27S RGE. 1 NE/W
Location as in quarters or footage from lines:
C W/2

Lease Owner J. A. Allison
Lease Name Pearson Well No. 2
Office Address 300 W. Douglas, Suite 305, Wichita, Ks. 67202
Character of Well (Completed as Oil, Gas or Dry Hole): dry hole
Date Well Completed 7/23/81
Application for plugging filed 7/23/81
Plugging commenced 7/23/81
Plugging completed 7/23/81

Locate Well
correctly on above
Section Platt.

Reason for abandonment of well or producing formation no commercial quantity of oil or gas encountered
Was permission obtained from the Conservation Division or it's Agent's before plugging was commenced? yes

Name of Conservation Agent who supervised plugging of this well Don Thompson
Producing formation _____ Depth to top _____ bottom _____ T.D. 3440
Show depth and thickness of all water, oil and gas formations.

OIL, GAS OR WATER RECORDS Casing Record

Formation	Content	From	To	Size	Put in	Pulled Out
surface hole	shale	surf	211	8-5/8	209	none

Describe in detail the manner in which the well was plugged, indicating where the mud fluid was placed and the method or methods used in introducing it into the hold. If cement or other plugs were used, state the character of same and depth placed, from _____ feet to _____ feet for each plug set.

1/2 sx hulls, plug, 30 sx @ 215'
1/2 sx hulls, plug, 15 sx @ 40'
5 sx rat hole

(If additional description is necessary, use the BACK of this sheet)
Name of Plugging Contractor 515 R. H. Garvey Building
Wichita, Kansas 67202

STATE OF Kansas COUNTY OF Sedgwick, ss.
James L. Donelson, Jr. (employee of owner) or (owner or operator) of the above-described well, being first duly sworn on oath, says: That I have knowledge of the facts, statements, and matters herein contained and the log of the above-described well as filed and that the same are true and correct. So help me God.

JUN 29 1983

(Signature) James L. Donelson, Jr.
515 R.H. Garvey Bldg., Wichita, Ks.
(Address) 67202

SUBSCRIBED AND SWORN TO before me this 24th day of July, 19 81

My Commission expires: April 30, 1983

Dorothy L. Schmidt
Dorothy L. Schmidt Notary Public

DOROTHY L. SCHMIDT
STATE NOTARY PUBLIC
Sedgwick County, Kansas
My Appt. Exp. April 30, 1983

KANSAS

WELL COMPLETION REPORT AND
DRILLER'S LOG

API No. 15 — 173 — 20,398
County Number

Operator
J. A. Allison

Address
300 W. Douglas, Suite 305 - Wichita, Kansas 67202

Well No. #2 Lease Name Pearson

Footage Location
2310 feet from ~~SE~~ (S) line 1320 feet from ~~SE~~ (W) line

Principal Contractor DNB Drilling, Inc. Geologist Allen S. Munroe


Spud Date 7/15/81 Date Completed 7/23/81 Total Depth 3440' P.B.T.D.

Directional Deviation Oil and/or Gas Purchaser

S. 5 T. 27S R. 1 ^{EW}
Loc. C N/2 N/2 SW

County Sedgwick

640 Acres
N

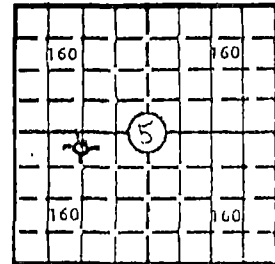

Locate well correctly

Elev.: Gr. 1347

DF 1352 KB 1355

CASING RECORD

Report of all strings set — surface, intermediate, production, etc.

Purpose of string	Size hole drilled	Size casing set (in O.D.)	Weight lbs/ft.	Setting depth	Type cement	Sacks	Type and percent additives
Surface	12 1/4"	8 5/8"	24#	211'	Common	175	3% cc

LINER RECORD

PERFORATION RECORD

Top, ft.	Bottom, ft.	Sacks cement	Shots per ft.	Size & type	Depth interval

TUBING RECORD

Size	Setting depth	Packer set at

ACID, FRACTURE, SHOT, CEMENT SQUEEZE RECORD

Amount and kind of material used	Depth interval treated

RECEIVED
STATE CORPORATION COMMISSION
JUN 29 1983
CONSERVATION DIVISION
Wichita, Kansas

INITIAL PRODUCTION

Date of first production	Producing method (flowing, pumping, gas lift, etc.)
RATE OF PRODUCTION PER 24 HOURS	Oil bbls. Gas MCF Water bbls. Gas-oil ratio CFPB
Disposition of gas (vented, used on lease or sold)	Producing interval (s)

INSTRUCTIONS: As provided in KCC Rule 82-2-125, within 90 days after completion of a well, one completed copy of this Drillers Log shall be transmitted to the State Geological Survey of Kansas, 4150 Monroe Street, Wichita, Kansas 67209. Copies of this form are available from the Conservation Division, State Corporation Commission, 245 No. Water, Wichita, Kansas 67202. Phone AC 316-522-2206. If confidential custody is desired, please note Rule 82-2-125. Drillers Logs will be on an open file in the Oil and Gas Division, State Geological Survey of Kansas, Lawrence, Kansas 66044.

Operator J. A. Allison		DESIGNATE TYPE OF COMPLETION: OIL, GAS, DRY HOLE, WDW, ETC.:
Well No. #2	Lease Name Pearson	Dry Hole
S <u>5</u> T <u>27S</u> R <u>1</u> ^{EX} _W		

WELL LOG


Show all important zones of porosity and contents thereof; cored intervals, and all drill-stem tests, including depth interval tested, cushion used, time tool open, flowing and shut-in pressures, and recoveries.

SHOW GEOLOGICAL MARKERS, LOGS RUN, OR OTHER DESCRIPTIVE INFORMATION.

FORMATION DESCRIPTION, CONTENTS, ETC.	TOP	BOTTOM	NAME	DEPTH
DST #1, op 30, si 45; op 60, si 45; recovered 90' heavy oil and gas cut mud, 180' gas in pipe, free oil top of tool. ISIP 1054, FSIP 927; IFP 21-21, FFP 21-32.	3399'	3440'	<u>ELEC. LOG TOPS</u>	
			Kansas City	2790 (-1435)
			B/Kansas City	2984 (-1629)
			Marmaton	3050 (-1695)
			Cherokee	3218 (-1863)
			Eros. Miss.	3410 (-2055)
			Miss. Dolo.	3424 (-2069)
			R.T.D.	3440 (-2085)
			L.T.D.	3439 (-2084)

NOTE: This hole had severe lost circulation @ 2845'.

USE ADDITIONAL SHEETS, IF NECESSARY, TO COMPLETE WELL RECORD.

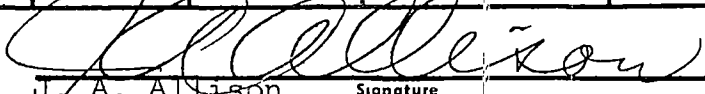Date Received	 J. A. Allison Operator
	Signature
	Title
	August 25, 1981 Date