

This form shall be filed in duplicate with the Kansas Corporation Commission, 200 Colorado Derby Building, Wichita, Kansas 67202, within ten days after the completion of the well, regardless of how the well was completed.

Attach separate letter of request if the information is to be held confidential. If confidential, only file one copy. Information on side one will be of public record and side two will then be held confidential.

Circle one: (Oil) Gas, Dry, SWD, OWWO, Injection. Type and complete ALL sections. Applications must be filed for dual completion, commingling, SWD and injection.

Attach wireline logs (i.e. electrical log, sonic log, gamma ray neutron log, etc.). KCC # (316) 263-3238. (Rules 82-2-105 & 82-2-125)

OPERATOR Cascade Oil Company

API NO. 15-009-22,660 9990

ADDRESS 1518 W. 6th

COUNTY Barton

El Dorado, KS 67042

FIELD Sunny Valley

**CONTACT PERSON Paul Fiacco

PROD. FORMATION

PHONE 316-321-6720

LEASE Sessler

PURCHASER Inland

WELL NO. #1

ADDRESS 200 Douglas Building

WELL LOCATION NE NE NW

Wichita, KS 67202

2310 Ft. from West Line and

DRILLING Heartland Drilling, Inc.

440 Ft. from North Line of

CONTRACTOR

ADDRESS Suite 600 - One Main Place

the NW/4 SEC. 18 TWP. 20S RGE. 12W

Wichita, KS 67202-1399

PLUGGING Heartland Drilling, Inc.

CONTRACTOR

ADDRESS Suite 600 - One Main Place

Wichita, KS 67202-1399

TOTAL DEPTH 4197' PBD


SPUD DATE Jan. 31, 1982 DATE COMPLETED Feb. 11, 1982

ELEV: GR 1855 DF KB 1861

DRILLED WITH (CABLE) (ROTARY) (AIR) TOOLS

Amount of surface pipe set and cemented 319.50 DV Tool Used?

WELL PLAT

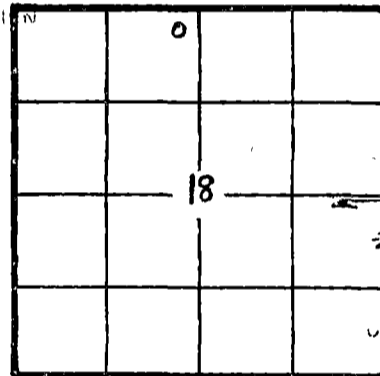

KCC (Office Use) KGS

MAY 25 1982 CONSERVATION DIVISION Wichita, Kansas

AFFIDAVIT

STATE OF Kansas, COUNTY OF Butler SS, I,

Paul Fiacco OF LAWFUL AGE, BEING FIRST DULY SWORN UPON HIS OATH,

DEPOSES THAT HE IS Operations Manager (FOR)(OF) Cascade Oil Company, Inc.

OPERATOR OF THE Sessler LEASE, AND IS DULY AUTHORIZED TO MAKE

THIS AFFIDAVIT FOR AND ON THE BEHALF OF SAID OPERATOR, THAT WELL NO. #1 ON

SAID LEASE HAS BEEN COMPLETED AS OF THE 11 DAY OF February, 19 82, AND THAT

ALL INFORMATION ENTERED HEREIN WITH RESPECT TO SAID WELL IS TRUE AND CORRECT.

FURTHER AFFIANT SAITH NOT.

(S) Paul Fiacco

SUBSCRIBED AND SWORN BEFORE ME THIS 26 DAY OF April, 19 82.

BETTY HOWARD NOTARY PUBLIC My Appt. Expires 10/10/84

Betty Howard NOTARY PUBLIC

**The person who can be reached by phone regarding any questions concerning this information. Within 45 days of completion, a witnessed initial test by the Commission is required if the well produces more than 25 BOPD or is located in a Basic Order Pool.

SIDE TWO

WELL LOG

Show all important zones of porosity and contents thereof; cored intervals, and all drill-stem tests, including depth interval tested, cushion used, time tool open, flowing and shut-in pressures, and recoveries.

SHOW GEOLOGICAL MARKERS, LOGS RUN, OR OTHER DESCRIPTIVE INFORMATION.

FORMATION DESCRIPTION, CONTENTS, ETC.	TOP	BOTTOM	NAME	DEPTH
Surface	0	330		
Shale & Red Bed	330	1200		
Shale	1200	3025		
Shale & Lime Stks.	3025	3215		
Shale & Lime	3215	3690		
Lime & Dolomite	3690	3795		
Shale	3795	3805		
Shale & Lime	3805	3810		
Chert	3810	3850		
Shale & Lime & Chert	3850	3910		
Shale & Lime Stks.	3910	3970		
Lime & Chert	3970	4197		

Report of all strings set — surface, intermediate, production, etc. CASING RECORD (New) or (Used)

Purpose of string	Size hole drilled	Size casing set (in O.D.)	Weight lbs/ft.	Setting depth	Type cement	Sacks	Type and percent additives
Surface	12 1/4"	8 5/8"	20#	319.50	Common	300	3% CaCl 2% gel
Production		5 1/2"	14#	4196'	60-40 pozmix	250	10% salt 3/4 or 1% CFR2 w/2 lbs gilsonite per sack

LINER RECORD

PERFORATION RECORD

Top, ft.	Bottom, ft.	Sacks cement	Shots per ft.	Size & type	Depth interval

TUBING RECORD		
Size	Setting depth	Packer set at

ACID, FRACTURE, SHOT, CEMENT SQUEEZE RECORD

Amount and kind of material used	Depth interval treated

Date of first production	Producing method (flowing, pumping, gas lift, etc.)	Gravity
RATE OF PRODUCTION PER 24 HOURS	Oil bbls.	Gas bbls.
	Water %	Gas-oil ratio CFPB
Disposition of gas (vented, used on lease or sold)		Perforations