

This form shall be filed in duplicate with the Kansas Corporation Commission, 200 Colorado Derby Building, Wichita, Kansas 67202, within ten days after the completion of the well, regardless of how the well was completed.

Attach separate letter of request if the information is to be held confidential. If confidential, only file one copy. Information on side one will be of public record and side two will then be held confidential.

Circle one: Oil, Gas, Dry, SWD, OWWO, Injection Type and complete ALL sections. Applications must be filed for dual completion, commingling, SWD and injection, T.A.

Attach wireline logs (i.e. electrical log, sonic log, gamma ray neutron log, etc.). KCC # (316) 263-3238. (Rules 82-2-105 & 82-2-125)

OPERATOR Banks Oil Company

API NO. 15-009-22,654 0000

ADDRESS 200 W. Douglas, #550
Wichita, Kansas 67202

COUNTY Barton
FIELD

**CONTACT PERSON Lee Banks
PHONE (316) 267-0783

PROD. FORMATION N/A

PURCHASER N/A

LEASE Adams

ADDRESS


WELL NO. 2

DRILLING D. R. Lauck Oil Company
CONTRACTOR
ADDRESS 221 S. Broadway
Wichita, Kansas 67202

WELL LOCATION S/2 NE SW
1750 Ft. from South Line and
2010 Ft. from West Line of
the SW/4 SEC. 34 TWP. 20S RGE. 13W

PLUGGING Allied Cementing Company
CONTRACTOR
ADDRESS Box 31
Russell, Kansas 67665

WELL PLAT

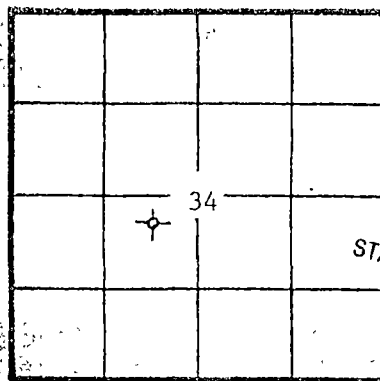

KCC _____
KGS _____
(Office Use)

RECEIVED
STATE CORPORATION COMMISSION

AUG 17 1983

SUPERVISION DIVISION
Wichita, Kansas

TOTAL DEPTH 3625' PBTD

SPUD DATE 1/17/82 DATE COMPLETED 1/22/82

ELEV: GR 1884' DF KB 1889'

DRILLED WITH (CABLE) (ROTARY) (AIR) TOOLS

Amount of surface pipe set and cemented 253' DV Tool Used? N/A

A F F I D A V I T

STATE OF Kansas, COUNTY OF Sedgwick, SS, I, Lee Banks

OF LAWFUL AGE, BEING FIRST DULY SWORN UPON HIS OATH,

DEPOSES THAT HE IS (FOR) (OF)

OPERATOR OF THE Adams No. 2 LEASE, AND IS DULY AUTHORIZED TO MAKE

THIS AFFIDAVIT FOR AND ON THE BEHALF OF SAID OPERATOR, THAT WELL NO. 2 ON

SAID LEASE HAS BEEN COMPLETED AS OF THE 22nd DAY OF January, 19 82, AND THAT

ALL INFORMATION ENTERED HEREIN WITH RESPECT TO SAID WELL IS TRUE AND CORRECT.

FURTHER AFFIANT SAITH NOT.

(S) [Signature]

SUBSCRIBED AND SWORN BEFORE ME THIS 9th DAY OF March, 1982.

[Signature]
NOTARY PUBLIC

MY COMMISSION EXPIRES: 2-28-86

**The person who can be reached by phone regarding any questions concerning this information. Within 45 days of completion, a witnessed initial test by the Commission is required if the well produces more than 25 BOPD or is located in a Basic Order Pool.

SIDE TWO

WELL LOG

NEW GEOLOGICAL MAPKERS, LOGS RUN, OR OTHER DESCRIPTIVE INFORMATION.

Show all important zones of porosity and contents thereof, cored intervals, and all drill-stem tests, including depth interval tested, cushion used, time tool open, flowing and shut-in pressures, and recoveries.

FORMATION DESCRIPTION, CONTENTS, ETC.	TOP	BOTTOM	NAME	DEPTH
Heebner 3142 -1253				
Toronto 3162 -1273				
Douglas 3179 -1290				
Brown Lime 3262 -1373				
Lansing 3276 -1387				
Base K.C. 3496 -1607				
Cong. Shale 3520 -1631				
Viola 3568 -1679				
Arbuckle 3595 -1706				
Clean Arbuckle 3612 -1723				

Report of all strings set— surface, intermediate, production, etc. CASING RECORD (New) or (Used)

Purpose of string	Size hole drilled	Size casing used (in. O.D.)	Weight lb./ft.	Setting depth	Type cement	Socks	Type and percent additives
Surface		8 5/8"	28#	253'	Common	175	2% Gel 3% CC

LINER RECORD

PERFORATION RECORD

Top, ft.	Bottom, ft.	Sacks cement	Shots per ft.	Size & type	Depth interval
N/A	N/A	N/A	N/A	N/A	N/A

TUBING RECORD

Size	Setting depth	Packer set at
N/A	N/A	N/A

ACID FRACTURE, SHOT CEMENT SQUEEZE RECORD

Amount and kind of material used	Depth interval treated
N/A	N/A

Date of first production	Producing method (flowing, pumping, gas lift, etc.)	Gravity		
N/A	N/A	N/A		
RATE OF PRODUCTION PER 24 HOURS	Oil	Gas	Water	Gas-oil ratio
	N/A	N/A	N/A	N/A
Disposition of gas (vented, used on lease or sold)		Perforations		
N/A		N/A		

WELL PLUGGING RECORD

Give All Information Completely
 Make Required Affidavit

COUNTY Barton SEC. 34 TWP. 20S RGE. 13W E/W
 Location as in quarters or footage from lines:
C S/2 NE SW

	34		
	*		

Locate Well
 correctly on above
 Section Platt.

Lease Owner Lee Banks, Banks Oil Company
 Lease Name Adams Well No. 2
 Office Address 200 W. Douglas, Suite 550, Wichita, Kansas 67202
 Character of Well (Completed as Oil, Gas or Dry Hole): Dry Hole
 Date Well Completed 1/23/82
 Application for plugging filed 2/3/82
 Plugging commenced 1/23/82
 Plugging completed 1/23/82
 Reason for abandonment of well or producing formation Dry Hole

Was permission obtained from the Conservation Division or it's
 Agent's before plugging was commenced? Yes

Name of Conservation Agent who supervised plugging of this well J. H. Metz

Producing formation _____ Depth to top _____ bottom _____ T.D. 3622'

Show depth and thickness of all water, oil and gas formations.

OIL, GAS OR WATER RECORDS

Casing Record

Formation	Content	From	To	Size	Put in	Pulled Out
		0	253'	8-5/8"	246'	None

Describe in detail the manner in which the well was plugged, indicating where the mud
 fluid was placed and the method or methods used in introducing it into the hold. If cement
 or other plugs were used, state the character of same and depth placed, from _____ feet
 to _____ feet for each plug set.

Plugged with 60 sacks cement at 600';
 40 sacks cement at 240'; plug and 10 sacks
 cement at 40'; and 10 sacks cement in rat hole.

(If additional description is necessary, use BACK of this sheet)

Name of Plugging Contractor Allied Cementing Co.

STATE OF KANSAS COUNTY OF SEDGWICK, ss.

John D. Knightley Agent (employee of owner) or (owner or operator) of the
 above-described well, being first duly sworn on oath, says: That I have knowledge of the
 facts, statements, and matters herein contained and the log of the above-described well as
 filed and that the same are true and correct. So help me God.

(Signature) [Signature]
 Address 221 S. Broadway, Wichita, KS 67202

SUBSCRIBED AND SWORN TO before me this 3rd day of February, 1982.

My Commission expires: March 12, 1983

NOTARY RECEIVED
 STATE CORPORATION COMMISSION
 STELLA J. LIPPS
 NOTARY PUBLIC
 STATE OF KANSAS
 My Appt. Exp. 3-12-83
 AUG 17 1982
 CONSERVATION DIVISION
 Wichita, Kansas