


STATE OF KANSAS
STATE CORPORATION COMMISSION

WELL PLUGGING RECORD

Give All Information Completely
Make Required Affidavit
Mail or Deliver Report to
Conservation Division
State Corporation Comm.
245 North Water
Wichita, KS 67202

LANE County. Sec. 15 Twp. 16S Rge. 28 E
Location as "NE/CNW/SW" or footage from lines
NW SW NW

Lease Owner Wenert Trich Oil & Gas
Lease Name Dixon Well No. 1
Office Address Box 1408 Longview, TX 75601
Character of Well (Completed as Oil, Gas or Dry Hole)
DRY HOLE

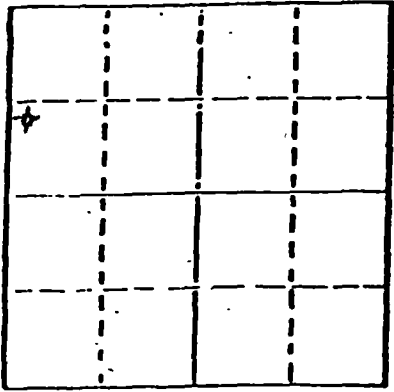

Date Well completed 7-15-82 19
Application for plugging filed 7-15-82 19
Application for plugging approved 7-15-82 19
Plugging commenced 7-15-82 19
Plugging completed 7-15-82 19

Reason for abandonment of well or producing formation
DRY & ABANDONED
If a producing well is abandoned, date of last production
19

Was permission obtained from the Conservation Division or
its agents before plugging was commenced? YES

Name of Conservation Agent who supervised plugging of this well STEVE DURANT
Producing formation _____ Depth to top _____ Bottom _____ Total Depth of Well _____
Show depth and thickness of all water, oil and gas formations.

OIL, GAS OR WATER RECORDS

CASING RECORD

FORMATION	CONTENT	FROM	TO	SIZE	PUT IN	PULLED OUT

Describe in detail the manner in which the well was plugged, indicating where the mud flui was placed and the method or methods used in introducing it into the hold. If cement or othe plugs were used, state the character of same and depth placed, from _____ feet to _____ feet for each plug set.

1st Plug @ 1020' w/80 Sax (50-50) Pox 3% cc 4% Gel
2nd Plug @ 390' w/40 sax
3rd Plug @ 40' w/10 sas
10 sks Rathole
CP @ 2:00 a.m. 7-15-82

RECEIVED
STATE CORPORATION COMMISSION
OCT 31 1983
CONSERVATION DIVISION
Wichita, Kansas

(If additional description is necessary, use BACK of this sheet)

Name of Plugging Contractor Gabbert-Jones, Inc.

STATE OF Sedgwick COUNTY OF Kansas, ss.
Jack W. Gabbert (employee of owner) or (owner) or (operator)
of the above-described well, being first duly sworn on oath, says: That I have knowledge of the facts, statements, and matters herein contained and the log of the above-described well as filed and that the same are true and correct. So help me God.

(Signature) Jack W. Gabbert
Jack W. Gabbert-Acting Agent
840 Sutton Place Wichita, Ks 67202
(Address)

SUBSCRIBED AND SWORN TO before me this 20th day of July, 1982

My commission expires 2-6-83

Elizabeth J. Edwards
Elizabeth J. Edwards Notary Public.