

This form shall be filed in duplicate with the Kansas Corporation Commission, 200 Colorado Derby Building, Wichita, Kansas 67202, within ten days after the completion of the well, regardless of how the well was completed.

Attach separate letter of request if the information is to be held confidential. If confidential, only file one copy. Information on side one will be of public record and side two will then be held confidential.

Circle one: Oil, Gas, Dry, SWD, OWWO, Injection. Type and complete ALL sections. Applications must be filed for dual completion, commingling, SWD and injection, T.A.

Attach wireline logs (i.e. electrical log, sonic log, gamma ray neutron log, etc.). KCC # (316) 263-3238. (Rules 82-2-105 & 82-2-125)

OPERATOR Pickrell Drilling Company

API NO. 15-095-21,217 0000

ADDRESS 110 N. Market, Suite 205

COUNTY Kingman

Wichita, Kansas 67202

FIELD Wildcat

\*\*CONTACT PERSON Jay McNeil

PROD. FORMATION N/A

PHONE 262-8427

LEASE Beck 'A'

PURCHASER

WELL NO. 1

ADDRESS

WELL LOCATION C SE SE

DRILLING CONTRACTOR Pickrell Drilling Company

660 Ft. from South Line and

CONTRACTOR

660 Ft. from East Line of


ADDRESS 110 N. Market, Suite 205

the SE/4 SEC. 10 TWP. 30S RGE. 6W

Wichita, Kansas 67202

WELL PLAT

PLUGGING CONTRACTOR Pickrell Drilling Company

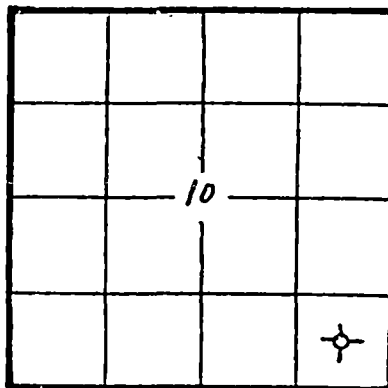

KCC \_\_\_ KGS \_\_\_ (Office Use)

ADDRESS 110 N. Market, Suite 205

Wichita, Kansas 67202

TOTAL DEPTH 4500 PBDT N/A

SPUD DATE 1/19/82 DATE COMPLETED 1/30/82

ELEV: GR 1415 DF 1417 KB 1420

DRILLED WITH (CABLE) (ROTARY) (AIR) TOOLS

Amount of surface pipe set and cemented 8 5/8" @ 215' w/165Sx DV Tool Used? No

AFFIDAVIT

STATE OF KANSAS, COUNTY OF Sedgwick SS, I,

C. W. Sebitts OF LAWFUL AGE, BEING FIRST DULY SWORN UPON HIS OATH,

DEPOSES THAT HE IS Attorney-In-Fact (FOR) (OF) Pickrell Drilling Company

OPERATOR OF THE Beck 'A' LEASE, AND IS DULY AUTHORIZED TO MAKE

THIS AFFIDAVIT FOR AND ON THE BEHALF OF SAID OPERATOR, THAT WELL NO. 1 ON

SAID LEASE HAS BEEN COMPLETED AS OF THE 30th DAY OF January, 19 82, AND THAT

ALL INFORMATION ENTERED HEREIN WITH RESPECT TO SAID WELL IS TRUE AND CORRECT.

FURTHER AFFIANT SAITH NOT.

RECEIVED STATE CORPORATION COMMISSION

AUG 08 1983

(S) [Signature] C. W. Sebitts

CONSERVATION DIVISION, Wichita, Kansas

February 3rd, 1982

SUE A. BROWNLEE NOTARY PUBLIC SUBSCRIBED AND SWORN BEFORE ME THIS Appt. Expires

[Signature] NOTARY PUBLIC

MY COMMISSION EXPIRES: February 24, 1985

\*\*The person who can be reached by phone regarding any questions concerning this information. Within 45 days of completion, a witnessed initial test by the Commission is required if the well produces more than 25 BOPD or is located in a Basic Order Pool.

**SIDE TWO**

**WELL LOG**

Show all important zones of porosity and contents thereof; cored intervals, and all drill-stem tests, including depth interval tested, cushion used, time tool open, flowing and shut-in pressures, and recoveries.

SHOW GEOLOGICAL MARKERS, LOGS RUN, OR OTHER DESCRIPTIVE INFORMATION.

| FORMATION DESCRIPTION, CONTENTS, ETC.   | TOP | BOTTOM | NAME  | DEPTH  |
|---|-----|--------|---|--|
| DST #1: 1988-2012 (Indian Cave)<br>30"-60"-10"-out<br>rec 30' mud<br>IFP 47#-67#<br>FFP 57#-57#<br>ISIP 734#                      |     |        | KB Log Tops:<br>Heebner<br>Lansing<br>Kansas City<br>Mississippi<br>Kinderhook<br>Simpson | 2990<br>3242<br>3512<br>4092<br>4386<br>4497 |
| DST #2: 3685-3720 (Hertha)<br>30"-60"-60"-90"<br>rec 1305' water<br>IFP 174#-298#<br>FFP 401#-586#<br>ISIP 1400#<br>FSIP 1400#    |     |        | RTD<br>LTD  | 4500<br>4500                                 |
| DST #3: 4485-4500 (Simpson)<br>30"-60"-60"-90"<br>rec 3660' SGCW<br>IFP 789#-1268#<br>FFP 1223#-1404#<br>ISIP 1581#<br>FSIP 1623# |     |        |   |  |

Report of all strings set — surface, intermediate, production, etc. **CASING RECORD** (New) or (Used)

| Purpose of string | Size hole drilled | Size casing set (in O.D.) | Weight lbs/ft. | Setting depth | Type cement | Sacks | Type and percent additives |
|-------------------|-------------------|---------------------------|----------------|---------------|-------------|-------|----------------------------|
| Surface           | 12 3/4            | 8 5/8"                    | 20#            | 215'          | Common      | 165   | Pozmix (3-2)               |
|                   |                   |                           |                |               |             |       |                            |
|                   |                   |                           |                |               |             |       |                            |

**LINER RECORD**

**PERFORATION RECORD**

| Top, ft. | Bottom, ft. | Sacks cement | Shots per ft. | Size & type | Depth interval |
|----------|-------------|--------------|---------------|-------------|----------------|
|          |             |              |               |             |                |

**TUBING RECORD**

| Size | Setting depth | Packer set at |
|------|---------------|---------------|
|      |               |               |

**ACID, FRACTURE, SHOT, CEMENT SQUEEZE RECORD**

| Amount and kind of material used | Depth interval treated |
|----------------------------------|------------------------|
|                                  |                        |
|                                  |                        |

| Date of first production | Producing method (flowing, pumping, gas lift, etc.) | Gravity |
|--------------------------|---|---------|
|                          |   |         |

| RATE OF PRODUCTION PER 24 HOURS | Oil bbls. | Gas MCF | Water % | Gas-oil ratio bbls. | CFPB |
|---------------------------------|-----------|---------|---------|---------------------|------|
|                                 |           |         |         |                     |      |

| Disposition of gas (vented, used on lease or sold) | Perforations |
|--|--------------|
|  |              |

STATE OF KANSAS  
STATE CORPORATION COMMISSION

WELL PLUGGING RECORD

Give All Information Completely  
Make Required Affidavit  
Mail or Deliver Report to  
Conservation Division  
State Corporation Comm.  
245 North Water  
Wichita, KS 67202

Kingman County. Sec. 10 Twp. 30S Rge. 6 XX/W  
Location as "NE/CNW/SW" or footage from lines  
C SE SE

Lease Owner Pickrell Drilling Company  
Lease Name Beck 'A' Well No. 1

Office Address 205 Litwin Building, Wichita, Kansas 67202  
Character of Well (Completed as Oil, Gas or Dry Hole) \_\_\_\_\_

D & A

Date Well completed 1/30/82 19  
Application for plugging filed 1/29/82 19  
Application for plugging approved 1/29/82 19  
Plugging commenced 1/30/82 19  
Plugging completed 1/30/82 19  
Reason for abandonment of well or producing formation \_\_\_\_\_

D & A

If a producing well is abandoned, date of last production  
N/A 19

Was permission obtained from the Conservation Division or  
its agents before plugging was commenced? Yes

Name of Conservation Agent who supervised plugging of this well \_\_\_\_\_

Producing formation N/A Depth to top \_\_\_\_\_ Bottom \_\_\_\_\_ Total Depth of Well \_\_\_\_\_

Show depth and thickness of all water, oil and gas formations.

OIL, GAS OR WATER RECORDS

CASING RECORD

| FORMATION | CONTENT | FROM | TO | SIZE   | PUT IN | PULLED OUT |
|-----------|---------|------|----|--------|--------|------------|
|           |         |      |    | 8 5/8" | 215'   | None       |
|           |         |      |    |        |        |            |
|           |         |      |    |        |        |            |
|           |         |      |    |        |        |            |

Describe in detail the manner in which the well was plugged, indicating where the mud fluid was placed and the method or methods used in introducing it into the hold. If cement or other plugs were used, state the character of same and depth placed, from \_\_\_\_\_ feet to \_\_\_\_\_ feet for each plug set.

60 Sx @ 550'  
40 Sx @ 200'  
10 Sx @ 40' with solid bridge plug  
10 Sx in rathole  
Completed 3:00 a.m. on 1/30/82

(If additional description is necessary, use BACK of this sheet)

Name of Plugging Contractor Pickrell Drilling Company

STATE OF KANSAS COUNTY OF Sedgwick, ss.

C. W. Sebitts (employee of owner) or (owner or operator)  
of the above-described well, being first duly sworn on oath, says: That I have knowledge of the facts, statements, and matters herein contained and the log of the above-described well as filed and that the same are true and correct. So help me God.

(Signature) [Signature]  
205 Litwin Building, Wichita, KS 67202  
(Address)

SUE A. BROWNLEE  
SUBSCRIBED AND SWORN TO before me this \_\_\_\_\_ day of \_\_\_\_\_, 1982  
STATE OF KANSAS  
Notary Expires \_\_\_\_\_

[Signature]  
Notary Public.

My commission expires February 24, 1985

RECEIVED  
STATE CORPORATION COMMISSION

AUG 08 1983

CONSERVATION DIVISION  
Wichita, Kansas