

R

## DISTRICT CONSERVATION AGENT'S REPORT

TO:

State Corporation Commission  
 Conservation Division  
 800 Bitting Building  
 Wichita, Kansas



FILE NO. 129-25LOCATION SENE NWSEC. 11 TWP. 27 RGE. 13Dry Hole        Abandoned Oil Well yes Abandoned Gas Well       

I have today completed supervision of plugging of:

Well No. A1 Lease HarrellOperator Atlantic Ry Co Address St Bend Kan Box 17Field Sukow County PrattTotal Depth 4930 Feet.

(Describe briefly the manner in which the well was plugged)

The well was cemented 4330 to 4320. Mud  
 4320 to 250 ft bridge cement to 250 to  
 to 220 ft. 15 sacks. Mud 220 to 15 ft cement  
 to base of cellar

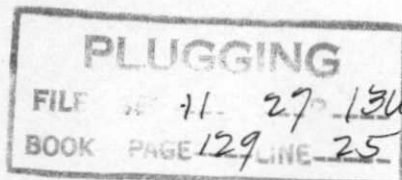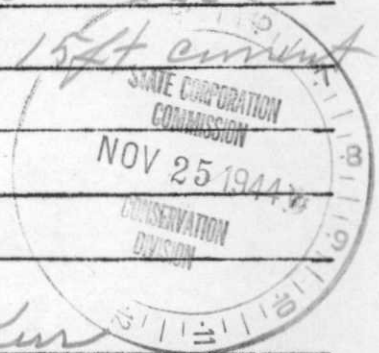

A. W. Kern  
 District Conservation Agent

Date 11-22-44