

15-009-20714-0000

STATE OF KANSAS  
STATE CORPORATION COMMISSION

Form CP-4


Give All Information Completely  
Make Required Affidavit  
Mail or Deliver Report to:  
Conservation Division  
State Corporation Commission  
P. O. Box 17027  
Wichita, Kansas 67217  
NORTH

WELL PLUGGING RECORD

Barton County. Sec. 8 Twp. 20S Rge. 12W (E) (W)  
NE SW SW

Location as "NE/CNWSW" or footage from lines \_\_\_\_\_  
Lease Owner Clinton Oil Company  
Lease Name Florence Kutina Well No. 1-V  
Office Address 217 N. Water, Wichita, Kansas  
Character of Well (completed as Oil, Gas or Dry Hole) D&A  
Date well completed February 12, 1973  
Application for plugging filed February 12, 1973  
Application for plugging approved February 12, 1973  
Plugging commenced February 12, 1973  
Plugging completed February 12, 1973  
Reason for abandonment of well or producing formation D&A

If a producing well is abandoned, date of last production \_\_\_\_\_ 19\_\_\_\_  
Was permission obtained from the Conservation Division or its agents before plugging was commenced? Yes

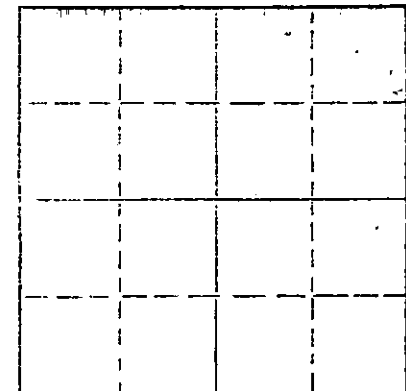

Locate well correctly on above  
Section Plat

Name of Conservation Agent who supervised plugging of this well Donald Truan  
Producing formation \_\_\_\_\_ Depth to top \_\_\_\_\_ Bottom \_\_\_\_\_ Total Depth of Well 3520 Feet  
Show depth and thickness of all water, oil and gas formations.

OIL, GAS OR WATER RECORDS

CASING RECORD

FORMATION	CONTENT	FROM	TO	SIZE	PUT IN	PULLED OUT
				10 3/4"	300'	-0-

Describe in detail the manner in which the well was plugged, indicating where the mud fluid was placed and the method or methods used in introducing it into the hole. If cement or other plugs were used, state the character of same and depth placed, from \_\_\_\_\_ feet to \_\_\_\_\_ feet for each plug set.

Plug hole w/50 sx cement @ 420'  
30 sx @ 240', plug & 1 sx hulls,  
15 sx @ 40'


RECEIVED  
STATE CORPORATION COMMISSION  
FEB 16 1973  
CONSERVATION DIVISION  
Wichita, Kansas

(If additional description is necessary, use BACK of this sheet)  
Name of Plugging Contractor Red Tiger Drilling Company  
Address 1720 Wichita Plaza, Wichita, Kansas

STATE OF Kansas COUNTY OF Sedgwick, ss.  
Gloria Fawcett (employee of owner) or (owner or operator) of the above-described well, being first duly sworn on oath, says: That I have knowledge of the facts, statements, and matters herein contained and the log of the above-described well as filed and that the same are true and correct. So help me God.

(Signature) Gloria Fawcett  
1720 Wichita Plaza, Wichita, Kansas  
(Address)

Subscribed and sworn to before me this 14th day of February, 19 73  
Virginia K. Albert  
My commission expires July 23, 1974 Notary Public.

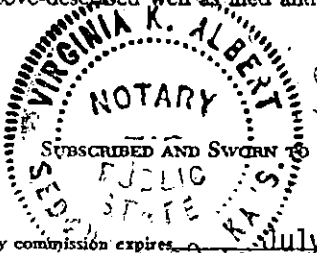

DRILLERS LOG

No. 1-V Florence Kutina

CASING RECORD:

10 3/4" @ 300'  
w/300 sx cement

COMPANY:

Clinton Oil Company

DESCRIPTION:

NE SW SW  
8-20S-12W  
Barton County,  
Kansas

CONTRACTOR:

Red Tiger Drilling Company

COMMENCED:

February 4, 1973

COMPLETED:

February 12, 1973

TOTAL DEPTH: 3520'

ELEVATION:

<u>FORMATION</u>	<u>FROM</u>	<u>TO</u>	<u>REMARKS</u>
Sand	0	160	
Hard sand	160	170	
Shale	170	302	
Red Bed, shale, shells & sand stringers	302	681	
Anhydrite	681	705	
Shale and shells	705	805	
Shales	805	1479	
Lime and shales	1479	2330	
Shale and shells	2330	2605	
Shale w/lime stringers	2605	2785	
Lime and shale	2785	2865	
Lime	2865	3074	
Shale (Heb.)	3074	3078	
Lime and shale	3078	3105	
Shale and sandy lime, BL and KC	3105	3230	
Lime	3230	3440	
Cong. L. Arbuckle	3440	3520	

RECEIVED  
STATE CORPORATION COMMISSION  
FEB 16 1973  
CONSERVATION DIVISION  
Wichita, Kansas

I certify that this is a true and correct copy of the above log to the best of my knowledge.

RED TIGER DRILLING COMPANY

Gloria Fawcett  
Gloria Fawcett

Subscribed and sworn to before me this 14th day of February, 1973.



Virginia K. Albert  
Notary Public

My Commission Expires: July 23, 1974