

Give All Information Completely
Make Required Affidavit
Mail or Deliver Report to:
Conservation Division
State Corporation Commission
800 Biting Building
Wichita, Kansas

OR

FORMATION PLUGGING RECORD

Strike out upper line
when reporting plug-
ging off formations.

NORTH

Locate well correctly on above
Section Plat

Barton County. Sec. 7 Twp. 20 Rge. 12W
Location as "NE $\frac{1}{4}$ NW $\frac{1}{4}$ SW $\frac{1}{4}$ " or footage from lines. N/2 NE SE

Lease Owner. Lindas & Keyes
Lease Name. Klepper Well No. 1
Office Address. % Keyes Drlg. Co. Ellinwood, Ks.
Character of Well (completed as Oil, Gas or Dry Hole) Dry Hole
Date well completed. 19
Application for plugging filed. 6-30-44 19
Application for plugging approved. 6-30-44 19
Plugging commenced. 6-28-44 19
Plugging completed. 6-30-44 19
Reason for abandonment of well or producing formation. Dry Hole

If a producing well is abandoned, date of last production. Dry Hole 19
Was permission obtained from the Conservation Division or its agents before plugging was commenced? Yes

Name of Conservation Agent who supervised plugging of this well. Eldon Petty
Producing formation. Depth to top. Bottom. Total Depth of Well. 3495 Feet
Show depth and thickness of all water, oil and gas formations.


OIL, GAS OR WATER RECORDS

CASING RECORD

Formation	Content	From	To	Size	Put In	Pulled Out

Describe in detail the manner in which the well was plugged, indicating where the mud fluid was placed and the method or methods used in introducing it into the hold. If cement or other plugs were used, state the character of same and depth placed, from feet to feet for each plug set.

Heavy mud 3495 to 365'. Cement to 300'.
Mud to 5'. Cement to 5'.

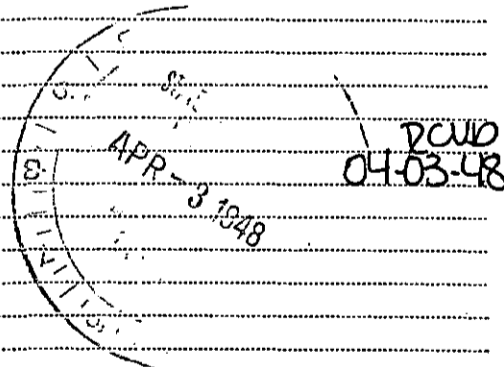

(If additional description is necessary, use BACK of this sheet)

Correspondence regarding this well should be addressed to Lindas & Keyes
Address. % Keyes Drilling Co. Ellinwood, Ks.

STATE OF Kansas, COUNTY OF Sedgewick, ss.

(employee of owner) or (owner or operator) of the above-described well,
being first duly sworn on oath, says: That I have knowledge of the facts, statements, and matters herein contained and the log of the above-described well as filed and that the same are true and correct. So help me God.

(Signature) Scott Huskey
(Address)

SUBSCRIBED AND SWORN to before me this 1st day of April, 1948
Catherine Dancy Notary Public.

My commission expires March 25, 1952 22-287 7-47-10M

PLUGGING
FILE SEC 7 T 20 R 1 W
BOOK PAGE 177 LINE 15

DRILLER'S LOG

John Lindsay & Keyes Drilling Co.
 Schartz No. 1
 SE 4 7-20-12 Barton County, Ks.

Well Commenced: June 8, 1944
 Well Completed: June 23, 1944

FROM	TO	FORMATION	REMARKS
0	120	Sand	
120	135	Pyrite of Iron	Started surface hole
135	155	Pyrite of Iron	Mixed 1 1/2 tons of mud
155	166	Iron	
166	225	Sand & Shale	
225	248	Red Rock	
248	265	Red Rock	Set surface pipe 2 1/2", cemented with 225 sacks
265	685	Red Bed	
685	720	Anhydrite Lime	
720	790	Red Rock & Shale	Drilled plug
790	1170	Shale	
1170	1250	Salt & Shale	
1250	1460	Salt & Shale	
1460	1555	Shale & Lime	
1555	1660	Shale & Shells	
1660	1800	Lime & Shale	
1800	1900	Broken Lime	
1900	1995	Lime & Shale	
1995	2095	Shale & Lime	
2095	2200	Shale & Shells	
2200	2365	Shale & Shells	
2365	2600	Shale & Shells	Slope Test at 2500
2600	2705	Lime-Broken	
2705	2770	Shale	
2770	2805	Lime	
2805	3085	Lime	
3085	3175	Lime & Shale	
3175	3186	Shale	
3186	3235	Lime	
3235	3270	Lime	
3270	3335	Lime - Broken	Circ. 1 1/2 hrs @ 3305
3335	3446	Lime	Trip @ 3446 to core cut 4' core Pulled 10 stands
3446	3450	Reamed	Reamed 4' core hole Circ 45 min. @ 3450 Circ 1 1/2 hr @ 3454
3450	3454	Lime	Took 3 1/2' core - No stain Circ 3457
3454	3463	Lime	Circ 1 1/2 @ 3463 Circ 6 1/2 @ 3466
3463	3466	Lime	Circ 3472 from 8:20 to 1:15
3466	3472	Lime	Took drill stem test, got 1 stand rotary mud, Circ. 1 hr 3479
3472	3495	Lime	Circ. 1 hr 3495

3495 Total Depth



I hereby certify that the above is a true and correct record of the drilling of the above well.

Dated this 3 day of July, 1944.

KEYES DRILLING COMPANY

By Geo W Keyes Partner

PLUGGING
 FILE SEC 7-T-20-R-170
 BOOK PAGE 177 LINE 15