


STATE OF KANSAS  
STATE CORPORATION COMMISSION  
200 Colorado Derby Bldg.  
Wichita, Kansas 67202

15-009-22577-0000  
Form CP-4  
Rev. 12-15-80

WELL PLUGGING RECORD

Give All Information Completely  
Make Required Affidavit

COUNTY Barton SEC. 7 TWP. 20s RGE. 12w E/W  
Location as in quarters or footage from lines:  
S/2 S/2 SE/4

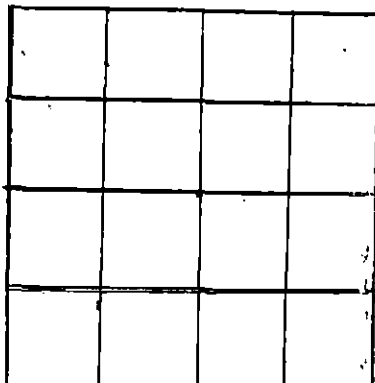

Locate Well  
correctly on above  
Section Platt.

Lease Owner Raymond Oil Co. Inc.  
Lease Name Schartz #7-1 Well No. \_\_\_\_\_  
Office Address One Main Place, Suite 900, Wichita, Kansas 67202  
Character of Well (Completed as Oil, Gas or Dry Hole): \_\_\_\_\_  
Date Well Completed \_\_\_\_\_  
Application for plugging filed \_\_\_\_\_  
Plugging commenced 5/19/83  
Plugging completed 6/1/83  
Reason for abandonment of well or producing formation \_\_\_\_\_

Depleted

Was permission obtained from the Conservation Division or it's  
Agent's before plugging was commenced? Yes

Name of Conservation Agent who supervised plugging of this well Marion Schmidt  
Producing formation \_\_\_\_\_ Depth to top \_\_\_\_\_ bottom T.D. 3597'

Show depth and thickness of all water, oil and gas formations.

OIL, GAS OR WATER RECORDS

Casing Record

Formation	Content	From	To	Size	Put in	Pulled Out
				8 5/8	306'	none
				5 1/2"	3597'	1072'

Describe in detail the manner in which the well was plugged, indicating where the mud  
fluid was placed and the method or methods used in introducing it into the hold. If cement  
or other plugs were used, state the character of same and depth placed, from \_\_\_\_\_ feet  
to \_\_\_\_\_ feet for each plug set.

Plugged off bottom with 5 sacks cement, sand to 3100' & 5 sacks cement.  
Shot pipe at 2889' & 2727'. Pipe parted at 1072'. Pulled 27 joints.  
Plugged well with 4 hulls, 12 gel, 65 cement, 3 gel, 1 hull, plug, & 100  
sacks 50/50 poz. 4% gel 3% c.c.

Plugging complete

(If additional description is necessary, use BACK of this sheet)

Name of Plugging Contractor Kelso Casing Pulling

STATE OF Kansas COUNTY OF Rice, ss.  
R. Darrell Kelso (employee of owner) or (owner or operator) of the  
above-described well, being first duly sworn on oath, says: That I have knowledge of the  
facts, statements, and matters herein contained and the log of the above-described well as  
filed and that the same are true and correct. So help me God.

(Signature) R. Darrell Kelso  
Box 347, Chase, Ks. 67524  
(Address)

SUBSCRIBED AND SWORN TO before me this 7th day of June, 19 83



My Commission expires: \_\_\_\_\_

Irene Hoover  
RECEIVED  
Notary Public.  
STATE CORPORATION COMMISSION

JUN 09 1983

CONSERVATION DIVISION  
Wichita, Kansas