


STATE OF KANSAS  
STATE CORPORATION COMMISSION

Give All Information Completely  
Make Required Affidavit  
Mail or Deliver Report to:  
Conservation Division  
State Corporation Commission  
211 No. Broadway  
Wichita, Kansas

WELL PLUGGING RECORD

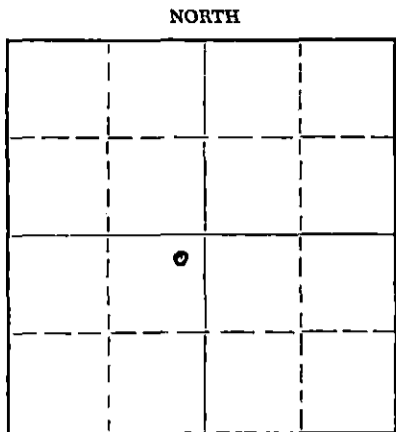

Locate well correctly on above  
Section Plat

Pratt County. Sec. 8 Twp. 27S Rge. 13W (E) (W)  
Location as "NE/CNW/SW" or footage from lines. NE NE SW  
Lease Owner Anschutz Drilling Co., Inc.  
Lease Name City of Pratt Well No. 1  
Office Address 709 Union Natl. Bldg., Wichita, Kansas  
Character of Well (completed as Oil, Gas or Dry Hole) Dry Hole  
Date well completed March 11 19 57  
Application for plugging filed March 11 19 57  
Application for plugging approved March 11 19 57  
Plugging commenced March 11 19 57  
Plugging completed March 12 19 57  
Reason for abandonment of well or producing formation Dry

If a producing well is abandoned, date of last production 19  
Was permission obtained from the Conservation Division or its agents before plugging was commenced? Yes

Name of Conservation Agent who supervised plugging of this well M. A. Rives  
Producing formation \_\_\_\_\_ Depth to top \_\_\_\_\_ Bottom \_\_\_\_\_ Total Depth of Well 4536 Feet  
Show depth and thickness of all water, oil and gas formations.

OIL, GAS OR WATER RECORDS

CASING RECORD

FORMATION	CONTENT	FROM	TO	SIZE	PUT IN	PULLED OUT
				8-5/8"	851'	

Describe in detail the manner in which the well was plugged, indicating where the mud fluid was placed and the method or methods used in introducing it into the hole. If cement or other plugs were used, state the character of same and depth placed, from \_\_\_\_\_ feet to \_\_\_\_\_ feet for each plug set.

Set bottom plug @ 350', cemented through drill pipe with 20 sacks cement.  
Set top plug @ 35', cemented with 10 sacks cement.

(If additional description is necessary, use BACK of this sheet)

Name of Plugging Contractor Anschutz Drilling Co., Inc.  
Address 709 Union Natl. Bldg., Wichita, Kansas

STATE OF Kansas, COUNTY OF Sedgwick, ss.  
Shirley Salley (employee of owner) or (owner or operator) of the above-described well, being first duly sworn on oath, says: That I have knowledge of the facts, statements, and matters herein contained and the log of the above-described well as filed and that the same are true and correct. So help me God.

(Signature) Shirley Salley  
709 Union Natl. Bldg., Wichita, Kansas  
(Address)

SUBSCRIBED AND SWORN TO before me this 14th day of March, 19 57

My commission expires April 27, 1959  
Kenneth R. Swenson  
Notary Public.

PLUGGING  
FILE SEC 8 T 27 R 13W  
BOOK PAGE 147 LINE 33

