


STATE OF KANSAS
STATE CORPORATION COMMISSION
Give All Information Completely
Make Required Affidavit
Mail or Deliver Report to:
Conservation Division
State Corporation Commission
800 Bitting Building
Wichita, Kansas

WELL PLUGGING RECORD
OR
FORMATION PLUGGING RECORD

Strike out upper line
when reporting plug-
ging off formations.

NORTH

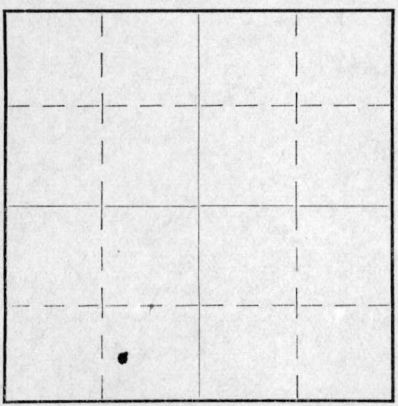

Locate well correctly on above
Section Plat

Pratt County. Sec. 11 Twp. 27 Rge. 13 (E) (W)
Location as "NE 1/4 NW 1/4 SW 1/4" or footage from lines. 660 from S line 990 from east
Lease Owner The Atlantic Refining Co.
Lease Name Hacker Well No. 1
Office Address P.O. Box 17 Great Bend Kansas
Character of Well (Completed as Oil, Gas or Dry Hole) Dry
Date, well completed 9-10-39 193
Application for plugging filed 9-16-39 Verbally 193
Application for plugging approved 9-18-39 193
Plugging Commenced 9-16-39 193
Plugging Completed 9-23-39 193
Reason for abandonment of well or producing formation Dry

If a producing well is abandoned, date of last production 193
Was permission obtained from the Conservation Division or its agents before plugging was commenced?
YES

Name of Conservation Agent who supervised plugging of this well C.T. Alexander
Producing formation Simpson Depth to top 4355 Bottom 4364 Total Depth of Well 4364 Feet.
Show depth and thickness of all water, oil and gas formations.


OIL, GAS OR WATER RECORDS

CASING RECORD

Formation	Content	From	To	Size	Put In	Pulled Out
Simpson Dolomite	Water	4355	4364	5 1/2 OD 10 3/4"	4355 381	2115 None

Describe in detail the manner in which the well was plugged, indicating where the mud fluid was placed and the method or methods used in introducing it into the hole. If cement or other plugs were used, state the character of same and depth placed, from _____ feet to _____ feet for each plug set.
Cement plug from 4340 to 4364.
Hole filled with mud laden fluid to bottom of surface pipe.
Cement plug from 375 to 395
Surface casing filled with mud laden fluid.
Cement plug from 0 to 15 feet.

PLUGGING
FILE SEC. 11 TWP. 27 RGE. 13
BOOK PAGE 76 LINE 15

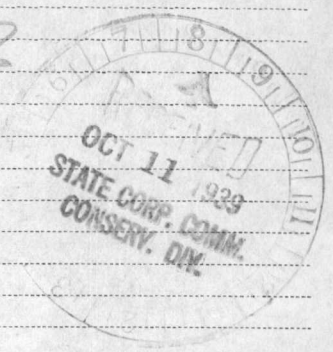

(If additional description is necessary, use BACK of this sheet)

Correspondence regarding this well should be addressed to The Atlantic Refining Co. Box 17 Great Bend Kansas.
Address _____

STATE OF Kansas, COUNTY OF Barton, ss.
I Dewey A. Jordan (employee of owner) or (owner or operator) of the above-described well,

being first duly sworn on oath, says: That I have knowledge of the facts, statements, and matters herein contained and the log of the above-described well as filed and that the same are true and correct. So help me God.

(Signature) Dewey Jordan

P.O. Box 17 Great Bend Kansas (Address)

SUBSCRIBED AND SWORN TO before me this 29th day of September, 1939

My commission expires May 21-1941

Notary Public

WELL RECORD

Block or Twp. 27S-13W

Lease HACKER
Lease No KS-6181
County Pratt

Well No. 1
State Kansas

Location Center W/2 SE SW 11-27S-13W.
Elevation 1941 Feet

Drilled { Contract
 { Company Tools

Contracted Depth
Completed Depth

Feet
Feet Date { Started 7-28-39
 { Completed 9-23-39
 { Deepened
 { Cleaned Out

Name of Contractor Big West Drilling Company

Contract Price Per Foot Day Work

Well Estimated Cost Method of Drilling
Well Actual Cost

BEFORE SHOOTING

AFTER SHOOTING

Initial Production Flowing Initial Production Flowing
Settled Production on Pump Settled Production on Pump
Baume Test Water With Oil %

Casing Record
SIZE SET PULLED
10 3/4" 381' w/275 sacks.
5 1/2" 17# 4357' w/200 cement &
6 sacks of aquagel.
Pulled 2105' of
5 1/2" pipe.

Torpedo Record
Date Company From To Feet Size of Shell Total Qts.
PERFORATED:
9-11-39 4355' to 4360' W/ 20 shots

FORMATION	TOP	BOTTOM	FORMATION	TOP	BOTTOM
Cellar	0	12	White lime	2005	2034
Surface clay	12	84	Brown shale	2034	2046
Sand	84	127	Gray lime	2046	2075
Yellow clay	127	184	Blue shale sticky	2075	2086
Red bed	184	334	Gray lime	2086	2094
White sand	334	346	Shale & Broken lime	2094	2141
Red bed	346	510	Gray lime	2141	2149
Red bed & shells	510	741	Blue shale	2149	2165
Shale	741	747	White broken lime	2165	2182
Lime (Anhydrate)	747	768	Blue shale	2182	2201
Shale & lime shells	768	842	Lime	2201	2205
Red bed w/broken blue shale	8842	985	Gray lime	2205	2225
Red & blue shale	985	1055	Blue shale	2225	2232
Lime	1055	1060	Gray sandy lime	2232	2263
Red & blue shale	1060	1225	Red & Blue shale	2263	2278
Blue shale & lime shells	1225	1300	Gray lime	2278	2292
Shale & shells	1300	1370	Gray lime & streaks of shale	2292	2351
Gray sandy shale	1370	1443	Gray lime	2351	2362
Gray sandy shale & salt	1443	1471	Blue shale	2362	2385
White lime	1471	1503	Broken lime	2385	2412
Blue shale & shells	1503	1587	Blue shale	2412	2438
White broken lime	1587	1598	Gray broken lime	2438	2485
Blue shale	1598	1740	Blue shale	2485	2497
White broken lime	1740	1770	Broken lime & shale	2497	2570
Blue shale	1770	1787	Blue shale & shells	2570	2596
White broken lime	1787	1810	Broken lime & shale	2596	2638
Lost circulation (Broken lime)	1810	1861	White lime	2638	2644
White broken lime	1861	1880	Gray lime	2644	2650
White lime	1880	1885	Blue shale	2650	2668
Gray broken lime	1885	1911	Broken lime & streaks of shale	2668	2913
White lime	1911	1949	White lime	2913	2931
Lime	1949	1961	Blue shale & streaks of broken lime	2931	2940
White lime	1961	1994	Blue shale & lime shells	2940	3007
Broken lime	1994	2005	Blue shale & shells	3007	3047

LOGGING
FILE NO. 11-127-13W
BOOK PAGE 76 LINE 15

OCT 11
STATE OF KANSAS
GEOLOGICAL SURVEY

