

STATE OF KANSAS
STATE CORPORATION COMMISSION

WELL PLUGGING RECORD

Give All Information Completely
Make Required Affidavit
Mail or Deliver Report to:
Conservation Division
State Corporation Commission
800 Bitting Building
Wichita, Kansas

Pratt County. Sec. 14 Twp. 27S Rge. 13W (H) (W)

Location as "NE/CNW%SW%" or footage from lines SE SE NW

Lease Owner K & E Drilling, Inc.

Lease Name Rolf Well No. 1

Office Address 1006 Central Building, Wichita, Kansas

Character of Well (completed as Oil, Gas or Dry Hole) Dry hole

Date well completed June 20 19 54

Application for plugging filed June 20 19 54

Application for plugging approved June 20 19 54

Plugging commenced 1:00 a.m., June 20 19 54


Plugging completed 8:00 a.m., June 20 19 54

Reason for abandonment of well or producing formation

Commercial quantity of oil not found

If a producing well is abandoned, date of last production 19

Was permission obtained from the Conservation Division or its agents before plugging was commenced? Yes

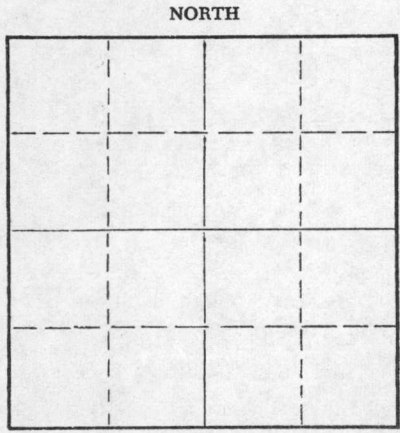

Locate well correctly on above Section Plat

Name of Conservation Agent who supervised plugging of this well M. A. Rives

Producing formation Depth to top Bottom Total Depth of Well 4395' Feet

Show depth and thickness of all water, oil and gas formations.

OIL, GAS OR WATER RECORDS

CASING RECORD

FORMATION	CONTENT	FROM	TO	SIZE	PUT IN	PULLED OUT
				8 5/8"	276'	

Describe in detail the manner in which the well was plugged, indicating where the mud fluid was placed and the method or methods used in introducing it into the hole. If cement or other plugs were used, state the character of same and depth placed, from feet to feet for each plug set.

Set plug @ 270' w/ 20 sacks cement
Set plug @ 40' w/ 10 sacks cement

RECEIVED
STATE CORPORATION COMMISSION
JUL 9 - 1954
CONSERVATION DIVISION
Wichita, Kansas

(If additional description is necessary, use BACK of this sheet)

Name of Plugging Contractor K & E DRILLING, INC.

Address 1006 Central Bldg., Wichita, Kansas

STATE OF Kansas, COUNTY OF Sedgwick, ss.
Clinton Engstrand (employee of owner) or (owner or operator) of the above-described

well, being first duly sworn on oath, says: That I have knowledge of the facts, statements, and matters herein contained and the log of the above-described well as filed and that the same are true and correct. So help me God.

(Signature) *Clinton Engstrand*

1006 Central Bldg., Wichita, Kansas (Address)

SUBSCRIBED AND SWORN to before me this 25 day of June, 19 54

Wilma Rogers
Notary Public.

My commission expires 10-29-55

PLUGGING
FILE SEC 14 T 27 R 13W
BOOK PAGE 42 LINE 29

