


STATE OF KANSAS  
STATE CORPORATION COMMISSION  
CONSERVATION DIVISION  
P. O. BOX 17027  
WICHITA, KANSAS 67217

FORM CP-4

WELL PLUGGING RECORD

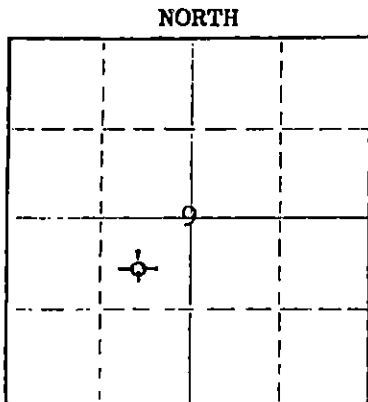

Locate well correctly on above Section Plat

Pratt County, Sec. 9 Twp. 27S Rge. 12W (EX) (W)  
Location as "NE/CNW/SE/SW" or footage from lines C NE SW  
Lease Owner Halliburton Oil Producing Company  
Lease Name Grimes Well No. 1  
Office Address Cameron Building, 2915 Classen Blvd., Okla. City, Okla.  
Character of Well (completed as Oil, Gas or Dry Hole) Dry Hole  
Date well completed September 15, 19 75  
Application for plugging filed September 15, 19 75  
Application for plugging approved September 15, 19 75  
Plugging commenced September 15, 19 75  
Plugging completed September 15, 19 75  
Reason for abandonment of well or producing formation Dry Hole

If a producing well is abandoned, date of last production \_\_\_\_\_ 19\_\_\_\_  
Was permission obtained from the Conservation Division or its agents before plugging was commenced? Yes

Name of Conservation Agent who supervised plugging of this well \_\_\_\_\_  
Producing formation \_\_\_\_\_ Depth to top \_\_\_\_\_ Bottom \_\_\_\_\_ Total Depth of Well 4425 Feet  
Show depth and thickness of all water, oil and gas formations.

OIL, GAS OR WATER RECORDS				CASING RECORD		
FORMATION	CONTENT	FROM	TO	SIZE	PUT IN	PULLED OUT
		0'	385'	8-5/8"	385'	None

Describe in detail the manner in which the well was plugged, indicating where the mud fluid was placed and the method or methods used in introducing it into the hole. If cement or other plugs were used, state the character of same and depth placed, from \_\_\_\_\_ feet to \_\_\_\_\_ feet for each plug set.

Spotted with 35 sacks cement at 300',  
15 sacks at 15', 2 sacks in rat hole.

(If additional description is necessary, use BACK of this sheet)  
Name of Plugging Contractor Halliburton Cementing Co.  
Address Great Bend, Kansas

STATE OF KANSAS COUNTY OF SEDGWICK ss.  
John D. Knightley, Agent (employee of owner) or (owner or operator) of the above-described well, being first duly sworn on oath, says: That I have knowledge of the facts, statements, and matters herein contained and the log of the above-described well as filed and that the same are true and correct. So help me God.

(Signature) John D. Knightley  
301 S. Broadway, Wichita, Kansas 67202  
(Address)

Subscribed and sworn to before me this 16th day of September, 19 75

My commission expires March 12, 1979 Stella J. Lippe Notary Public.

RECEIVED  
STATE CORPORATION COMMISSION  
SEP 17 1975  
CONSERVATION DIVISION  
Wichita, Kansas

Halliburton Oil Producing Company - Grimes #1  
C NE SW Sec. 9-27S-12W  
Pratt County, Kansas

Contractor: D. R. Lauck Oil Company, Inc.  
301 S. Broadway  
Wichita, Kansas 67202

Commenced: September 1, 1975  
Completed: September 15, 1975

Drillers Log

Sand	80
Shale	250
Red Bed	630
Shale	1760
Lime	1895
Lime & Shale	2230
Shale & Lime	2395
Lime & Shale	2665
Sand	2675
Lime & Shale	3235
Lime	3560
Shale & Lime	3715
Lime	4030
Lime & Shale	4110
Lime	4280
Lime & Chert	4425 RTD

RECEIVED  
STATE CORPORATION COMMISSION

SEP 17 1975

CONSERVATION DIVISION  
Wichita, Kansas