

RECEIVED
MAY 14 1976


15-151-20324-00-00

HALLIBURTON OIL PRODUCING CO.
COMP. CHECKED _____

STATE OF KANSAS
STATE CORPORATION COMMISSION
CONSERVATION DIVISION
P. O. BOX 17027
WICHITA, KANSAS 67217

FORM CP-4

WELL PLUGGING RECORD

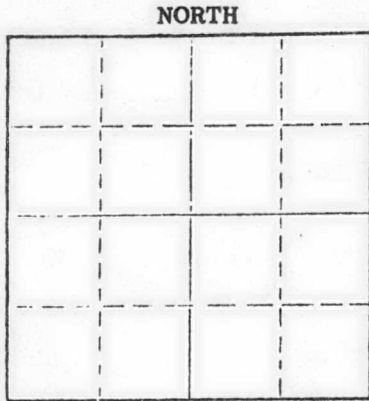

Locate well correctly on above Section Plat

Pratt County, Sec. 8 Twp. 27 Rge. 12 (E) (W)
Location as "NE/CNW&SW¼" or footage from lines SE NE SE
Lease Owner Halliburton Oil Producing
Lease Name Konald #1 Well No. _____
Office Address Oklahoma City, Oklahoma
Character of Well (completed as Oil, Gas or Dry Hole) _____
Date well completed _____ 19____
Application for plugging filed _____ 19____
Application for plugging approved _____ 19____
Plugging commenced 4/19/76 _____ 19____
Plugging completed 4/27/76 _____ 19____
Reason for abandonment of well or producing formation depleted.

If a producing well is abandoned, date of last production _____ 19____
Was permission obtained from the Conservation Division or its agents before plugging was commenced? yes

Name of Conservation Agent who supervised plugging of this well Biberstein
Producing formation _____ Depth to top _____ Bottom _____ Total Depth of Well 4345 Feet
Show depth and thickness of all water, oil and gas formations.

OIL, GAS OR WATER RECORDS

CASING RECORD

FORMATION	CONTENT	FROM	TO	SIZE	PUT IN	PULLED OUT
				10-3/4	400	none
				8-5/8	1414	777'

Describe in detail the manner in which the well was plugged, indicating where the mud fluid was placed and the method or methods used in introducing it into the hole. If cement or other plugs were used, state the character of same and depth placed, from _____ feet to _____ feet for each plug set.

Checked hole to 4345' and ran sand to 4300', ran 5 sacks cement.
Shot pipe at 830', 787', pulled 17 joints. Had welder weld on
10-3/4" collar, pumped 2 sacks hulls, 20 sacks gel and 150 sacks
cement.

PLUGGING COMPLETE.

RECEIVED
STATE CORPORATION COMMISSION

MAY 26 1976

CONSERVATION DIVISION
Wichita, Kansas

Name of Plugging Contractor KNIGHT CASING PULLING CO., INC.
Address CHASE, KANSAS

STATE OF KANSAS COUNTY OF RICE ss.

NOEL J. KNIGHT (employee of owner) or (owner or operator) of the above-described well, being first duly sworn on oath, says: That I have knowledge of the facts, statements, and matters herein contained and the log of the above-described well as filed and that the same are true and correct. So help me God.

(Signature) Noel Knight
CHASE, KANSAS

Subscribed and Sworn to before me this 11th day of May, 1976

My commission expires _____

NOTARY PUBLIC
MARGARET MELCHER
Rice County, Ks.
My Comm. Exp. Feb. 15, 1979

Margaret Melcher
Notary Public.

DRILLERS LOG

#1 KONOLD

CASING RECORD:

8 5/8" set at 1415'
w/ 150 sack cement

TOTAL DEPTH:
4345'

OPERATOR:

Halliburton Oil Producing Co.

CONTRACTOR:

Search Drilling Company

COMMENCED:

March 13, 1976

COMPLETED:

March 28, 1976

DESCRIPTION:

SE NE SE,
Sec. 8-27S-12W
Pratt County,
Kansas

<u>FORMATION</u>	<u>FROM</u>	<u>TO</u>	<u>REMARKS</u>
Sand	0	130	
Red Bed and Shale	130	1291	
Shale	1291	1442	
Lime and Shale	1442	1960	
Shale and Lime	1960	2103	
Shale, Lime and Chert	2103	2263	
Lime and Shale	2263	3246	
Shale and Lime	3246	3432	
Lime and Shale	3432	3794	
Shale and Lime	3794	3805	
Lime and Shale	3805	4345	
Rotary Total Depth	4345		Temporary Abandon

MAR 31 1976
 SEARCH DRILLING COMPANY
 Wichita, Kansas

I certify that this is a true and correct copy of the above log to the best of my knowledge.

SEARCH DRILLING COMPANY
R. M. Wendling
 R. M. Wendling

Subscribed and sworn to before me this 29th day of March, 1976.

My commission expires:
February 19, 1977

Maxine Dressen
 Maxine Dressen Notary Public

MAXINE DRESSEN
 NOTARY PUBLIC
 SEDGWICK COUNTY, KANSAS
 MY COMM. EXP. FEB. 19, 1977