


WELL PLUGGING RECORD

Give All Information Completely
Make Required Affidavit
Mail or Deliver Report to:
Conservation Division
State Corporation Commission
800 Bittling Building
Wichita, Kansas

NORTH

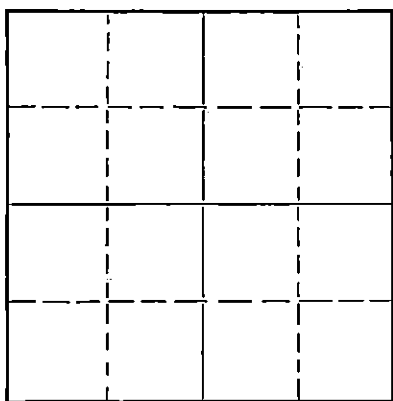

Locate well correctly on above
Section Plat

Pratt County. Sec. 8 Twp. 27 Rge. 12 (W)
Location as "NE/CNW $\frac{1}{4}$ SW $\frac{1}{4}$ " or footage from lines 360' E. Line 330' N. Line
Lease Owner Jackson-Lindsley Drilling Company et al
Lease Name Hoeme Well No. 1 A
Office Address 1103 Baker Avenue Great Bend, Kansas
Character of Well (completed as Oil, Gas or Dry Hole) Dry Hole
Date well completed November 11, 1950
Application for plugging filed November 11, 1950
Application for plugging approved November 11, 1950
Plugging commenced November 11, 1950
Plugging completed November 11, 1950
Reason for abandonment of well or producing formation
Dry Hole

If a producing well is abandoned, date of last production 19
Was permission obtained from the Conservation Division or its agents before plugging was commenced? Yes

Name of Conservation Agent who supervised plugging of this well Ruel Durkee
Producing formation Depth to top Bottom Total Depth of Well Feet
Show depth and thickness of all water, oil and gas formations.

OIL, GAS OR WATER RECORDS

CASING RECORD

Formation	Content	From	To	Size	Put In	Pulled Out
		0	4012	8 5/8"	412	None

Describe in detail the manner in which the well was plugged, indicating where the mud fluid was placed and the method or methods used in introducing it into the hole. If cement or other plugs were used, state the character of same and depth placed, from feet to feet for each plug set.

Filled with heavy mud to 310'. Set bridge 310'.
Ran in 15 sacks cement thru drill pipe
Filled with heavy mud to 15'.
Set plug @ 15'.
Dumped cement to fill to bottom of cellar.

RECEIVED
STATE CORPORATION COMMISSION
NOV 18 1950
CONSERVATION DIVISION
WICHITA, KANSAS

(If additional description is necessary, use BACK of this sheet)

Correspondence regarding this well should be addressed to Jackson-Lindsley Drilling Company
Address 1103 Baker Great Bend, Kansas

STATE OF Kansas, COUNTY OF Barton, ss.
A. L. Jackson (employee, owner, or operator) of the above-described well,
being first duly sworn on oath, says: That I have knowledge of the facts, statements, and matters herein contained and the log of the above-described well as filed and that the same are true and correct. So help me God.

(Signature) *A. L. Jackson*

(Address)

SUBSCRIBED AND SWORN to before me this 15 day of November 1950.

Wesley B. Brown
Notary Public.

My commission expires May 9, 1951

PLUGGING
FILE SEC 8 T 27 R 12

WELL LOG
Hoeme # 1A
Section 8 Township 27 Range 12 W.
Pratt County, Kansas

Started October 23, 1950
Completed November 11, 1950

Anhydrite 670
Kansas City 3704


0-120	Sand
120-412	Red shale and shells
412-670	Red bed and sand
670-690	Anhydrite
690-1690	Shale and shells
1690-2170	Lime and shale
2170-2325	Lime
2325-2425	Broken lime
2425-2540	Shale and shells
2540-2725	Lime and shale
2725-2810	Shale and lime
2810-2925	Shale and shells
2925-3035	Lime
3035-3255	Lime and shale
3255-3394	Lime
3394-3420	Sand
3420-4180	Lime
4180-4190	Cherty lime
4190-4230	Lime
4230-4245	Chert and lime
4245-4309	Lime
4309-4365	Lime and shale
4365-4375	Chert and lime
4375-4390	Lime, sand and shale
4390-4410	Sand and shale
4410-4415	Sand

4415 TOTAL ROTARY DEPTH

A F F I D A V I T

STATE OF Kansas, COUNTY OF Barton, SS

I, _____ of the JACKSON-LINDSLEY DRILLING Company being first duly sworn on oath, state; That I have knowledge of the facts, statements and matters herein contained and that the same are true and correct.

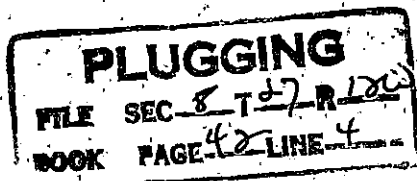

RECEIVED
Partner COMMISSION

NOV 18 1950

REGISTRATION DIVISION
Wichita, Kansas

Subscribed and sworn to before me this _____ day of _____, 1950.

My commission expires April 29, 1953.

Notary Public